

Name James Leaby

Service No. ^{36# 1869}
3296

Address 106 Blake Road

Lexington, Mass.

Location 106 Blake Road

Kind of Pipe

Size

Size of Main

~~Repair~~ - New Service

Location

Date	Material	Amount	Total	Date	Location	Amount
May 27, '47	Labor	1 05	1 05	May 27 '47	<i>Deposited Refunded Non-Charge</i>	15 00
	10% Overhead		11	Sept 25 '47		15 9
	31' - $\frac{3}{4}$ " Copper Tubing @ .27		8 37			13 43
	1 - $\frac{3}{4}$ " x $\frac{1}{2}$ " I.W.H. S & W		3 15	May 27, '47	Labor	4 85
	Trucking 1 hr. @ .75		75	May 28, '47	"	12 67
			13 43	14' - $\frac{3}{4}$ " Copper Tubing @ .27		3 78
				1 - $\frac{3}{4}$ " C Corp-cock		3 00
				1 - $\frac{3}{4}$ " C x $\frac{3}{4}$ " C Curb-cock		3 68
				1 - Box & Rod		4 26
				1 - $\frac{1}{2}$ " Offset Tail Piece		50
				1 - $\frac{1}{2}$ " Straight Tail Piece		50
				Trucking 1 hr. @ .75		75
	Labor					33 89

Hadley Press, Inc., Lexington

DATE _____

TOWN OF LEXINGTON—BOARD OF PUBLIC WORKS

WATER DIVISION

The undersigned applies for a supply of water at No. _____ St. and hereby agrees to comply with the rules and regulations as now, or at any future time, established by the Board of Selectmen.

Am't. of Estimate \$ _____

Owner _____


Am't. Paid \$ _____

Address _____

Builder _____

S. Town H.
Southville

Sketch of Service Here

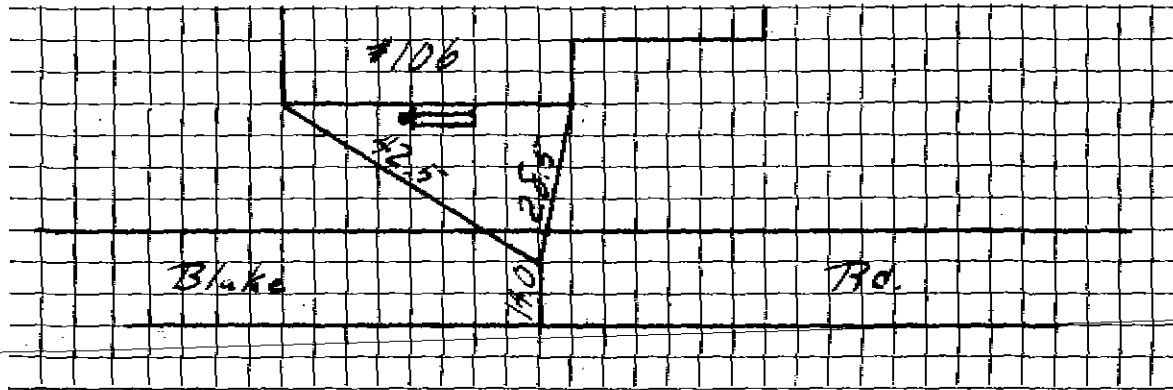

Connection made in _____ Street.

Work completed _____ 19

Remarks: