

Name S. E. Cliff

Service No. ~~38~~ <sup># 4492</sup> 280

Address ~~Simonds Road~~  
118 Blake

*J. P. Burr*  
*118 Blake Rd*

Location S. W. corner Blake & Simonds Rds. #118 Blake Rd

Kind of Pipe

Size

Size of Main

~~Repair~~ ~~Renewal~~ New Service

Location

| Date                  | Material  | Amount  | Total   | Date | Amount |
|-----------------------|---|---------|---------|------|--------|
| 9-19-33<br>Com. 15.75 | 29' 1" C.L. Pipe @.27                                 | \$7 83  |         |      |        |
|                       | 1 1" L.L. Coup.                                       | 16      |         |      |        |
|                       | 1 1" L.L. Ell.  | 22      |         |      |        |
|                       | 1 1" Br. Sp. Nip.                                     | 15      |         |      |        |
|                       | 1 S & W   | 2 75    | \$11 11 |      |        |
| 8/23/33               | 6 Hrs. Labor @.55                                     | 3 30    |         |      |        |
|                       | 3 " " @.60  | 1 80    | 5 10    |      |        |
|                       | 15% Overhead  |         | 77      |      |        |
|                       | <b>COST</b>   |         | \$16 98 |      |        |
| <b>CHARGE</b>         | 29' @ .45   | \$13 05 | \$13 05 |      |        |
|                       | <b>Labor</b>  |         |         |      |        |
|                       | <i>Overpayment of 2.71<br/>credit to Service # 22</i> |         |         |      |        |

*Aug. 31 1933 - Cash*

*15 75*

Reiley Press, Inc., Washington

S.W. corner Blake Road Simonds

DATE Aug. 31, 1933

### TOWN OF LEXINGTON—BOARD OF PUBLIC WORKS WATER DIVISION

The undersigned applies for a supply of water at No. 118 Blake Road St. and hereby agrees to comply with the rules and regulations as now, or at any future time, established by the Board of Selectmen.

Am't. of Estimate \$ 15.75

Owner J. E. Cliff


Am't. Paid \$ \_\_\_\_\_

Address Simonds Rd

Builder \_\_\_\_\_

Lexington

Sketch of Service Here

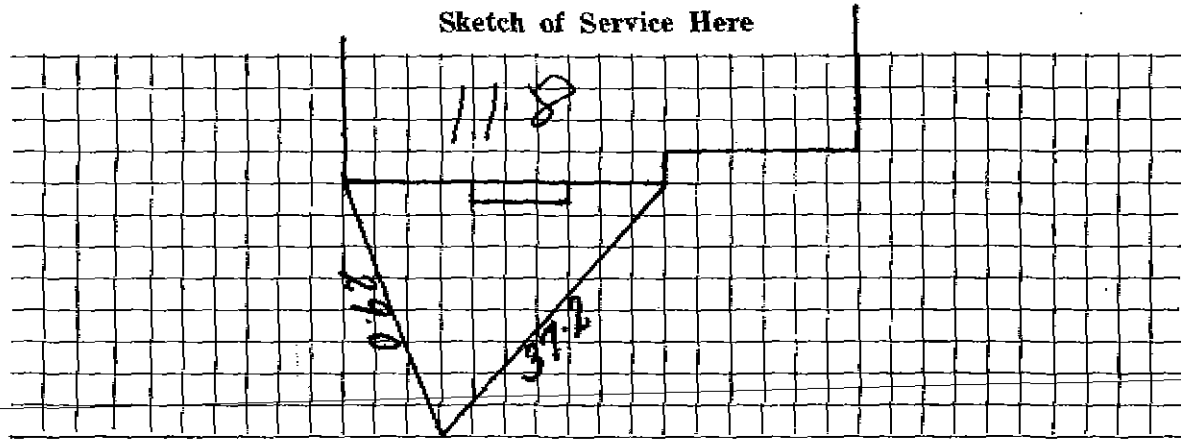

Connection made in \_\_\_\_\_ Street. Work completed \_\_\_\_\_ 19

Remarks: