

Address ~~Lexington Street, Burlington~~
127 Blake Rd.

Location Cor. Blake Road ~~& Eaton Rd.~~, #127

Kind of Pipe 127 Blake

Size

Size of Main

~~Repair~~ ~~Renewal~~ New Service

Location

Date	Material	Amount	Total	Date	Amount
Oct. 1, 1940	2 hrs. @ 60¢	1 20		November 21, 1940 Paid	11 73
Com 11/2/40	10% Overhead	12	1 32		
	37' 3/4" Copper tubing @ 18¢	6 66	2 25		
	1 3.4" C.x 1/2" I.S. & W.	2 25	1 50		
	2 hrs. trucking @ 75¢		11 73		
	Labor				

11/21/40 Settlement
11/2/40 " " with notes

Hadley Press, Inc., Lexington

DATE _____

TOWN OF LEXINGTON—BOARD OF PUBLIC WORKS

WATER DIVISION

The undersigned applies for a supply of water at No. 127 St. and hereby agrees to comply with the rules and regulations as now, or at any future time, established by the Board of Selectmen.

Am't. of Estimate \$ 14-

Owner

Francis W. Coffey
By Carl B. Hall


Am't. Paid \$ _____

Address

Builder

Carl B. Hall
Lexington, N. Burlington

Sketch of Service Here

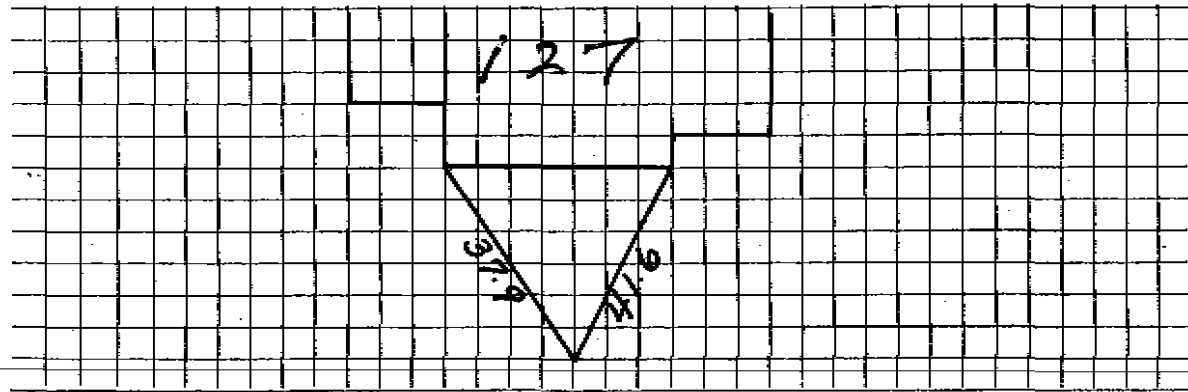

Connection made in _____ Street.

Work completed _____ 19 _____

Remarks: