

WATER SERVICE RECORD

Name **Mark Moore**

Service No. **43**

Address **17 Blake Road**

Location **Lot 2**

~~Removal of Sewer~~ **New Service DeFlice Bros Permit #298**

AUG 9 1965


Date	Material	Amount	Total	Date		Amount
5-27-65	74 3/4" Copper tubing			5-26-65	Deposit	82.00
					CURB TO MAIN	
				9-2-64	Labor 36.45	
					10% O.H. 3.65	40.10
					18' 3/4" Copper tubing @.42	7.57
					1 3/4" C Curb Cock	8.76
					1 3/4" C Corp Cock	7.41
					1 Box & Rod	4.90
					1 hr. Town Shovel @6.50	6.50
					1 hr. Trucking @3.00	3.00
					1 hr. Loader @4.00	4.00
						82.00

TOWN OF LEXINGTON — BOARD OF PUBLIC WORKS

WATER DIVISION

DATE _____

Sketch of Service Here

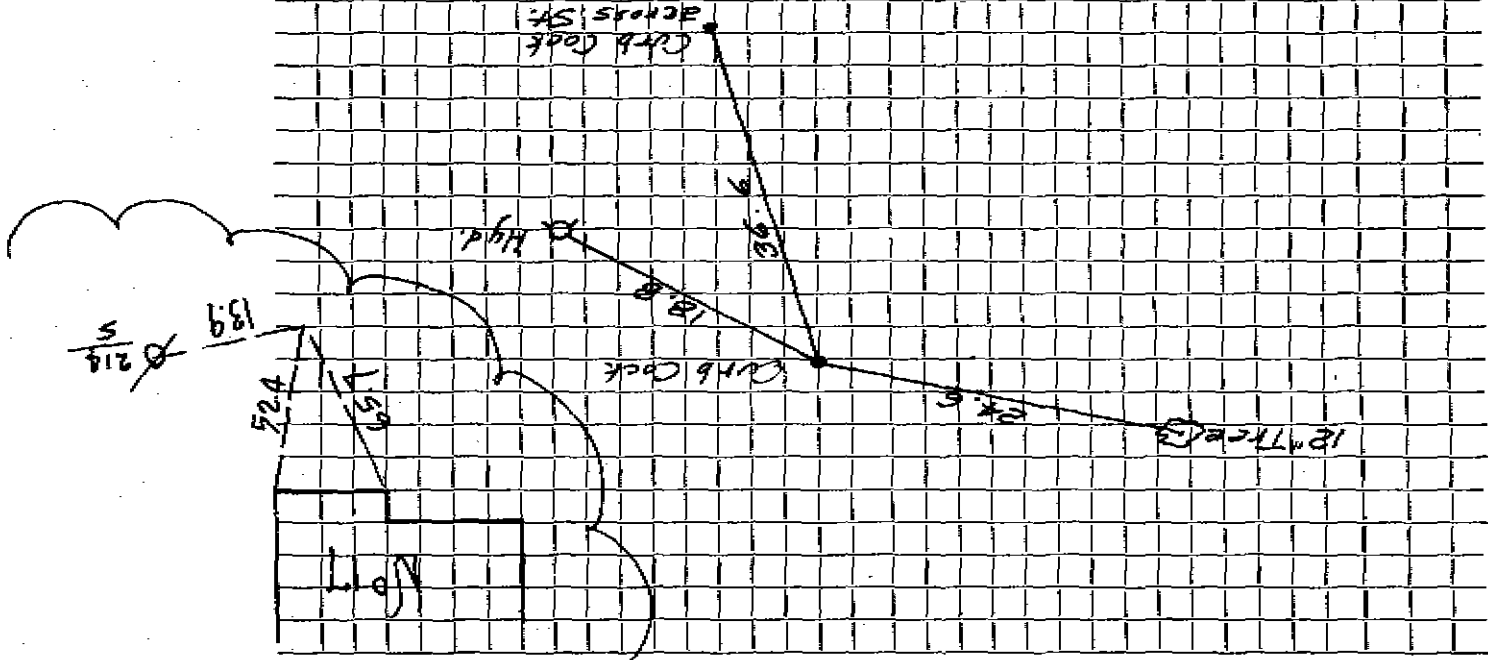

Connection made in _____

Street _____

Work completed _____

Remarks: _____