

WATER SERVICE RECORD

Name Fred S. Herson, Jr.

Service No. 217

Address 30 Blake Rd.

2449

Location Lexington

3438

~~Repair - General~~ New Service


Date	Material	Amount	Total	Date	Amount
8/18/53	Labor	15 50		7-11-53 Deposited	75 00
	10% overhead	1 55	17 05	7-14-53 Refunded	10 02
	57'-3/4" Copper Tubing @.3629		20 68		64 98
	1-3/4" C x 1/2 I.W.H. STOP & WASTE		4 00	8/18/53 Labor	22 00
	3 hrs. Littlefield Shovel @7.50		22 50	12'-3/4" Copper Tubing @.3629	4 35
	1 Hr. Trucking		75	1-3/4" C. Corp-cock	4 33
			64 98	1-3/4" C x 3/4" C. Curb-cock	4 67
				1-Box & Rod	3 90
				1-1/2" straight tail piece	50
				1-1/2" offset tail piece	50
				1 Hr. Littlefield Shovel	7 50
				1 Hr. Trucking	75
					48 50

DATE _____

TOWN OF LEXINGTON — BOARD OF PUBLIC WORKS

WATER DIVISION

Sketch of Service Here

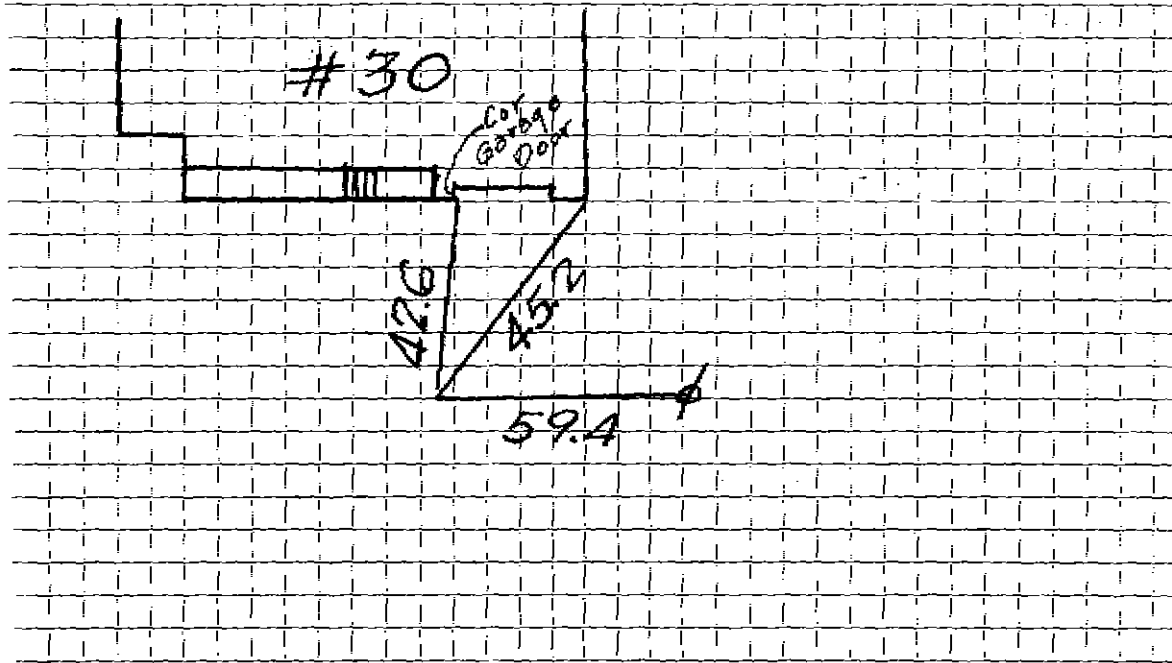

Connection made in Street. Work completed

Remarks:

.....

.....