

Name - Decland Construction Co.

Service No. 217

Address 33 Blake Road
Lexington, Mass.

Location 33 Blake Road

Kind of Pipe

Size

Size of Main

~~Repair - Renewal~~ - New Service

Com. 11-6-50

Location

Date

Material

Amount

Total

Date

Amount

Aug. 31, '50

Labor 5 10

5 10

Aug 31 50
11-6-50
Deported
Submitt

35 00

10% Overhead

51

12

39' - 3/4" Copper Tubing @.275

10 73

No Charge

53 38

1 - 3/4" C x 1/2" I.W.H. S&W

3 29

Aug. 31, '50 Labor

5 10

Littlefield Shovel 2 hrs. @ 7.00

14 00

19' - 3/4" Copper Tubing @.275

5 23

Trucking 1 hr. @ .75

75

1 - 3/4" C Corp-cock

3 15

34 38

1 - 3/4" C x 3/4" C Barb-cock

3 85

1 - Box & Rod

3 35

1 - 1/2" Offset Tail Piece

42

1 - 1/2" Straight Tail Piece

42

Littlefield Shovel 2 hrs. @ 7.00

14 00

Trucking 1 hr. @ .75

75

Labor

36 27

DATE _____

TOWN OF LEXINGTON—BOARD OF PUBLIC WORKS

WATER DIVISION

The undersigned applies for a supply of water at No. _____ St. and hereby agrees to comply with the rules and regulations as now, or at any future time, established by the Board of Selectmen.

Am't. of Estimate \$ _____


Owner _____

Am't. Paid \$ _____

Address _____

Builder _____

Sketch of Service Here

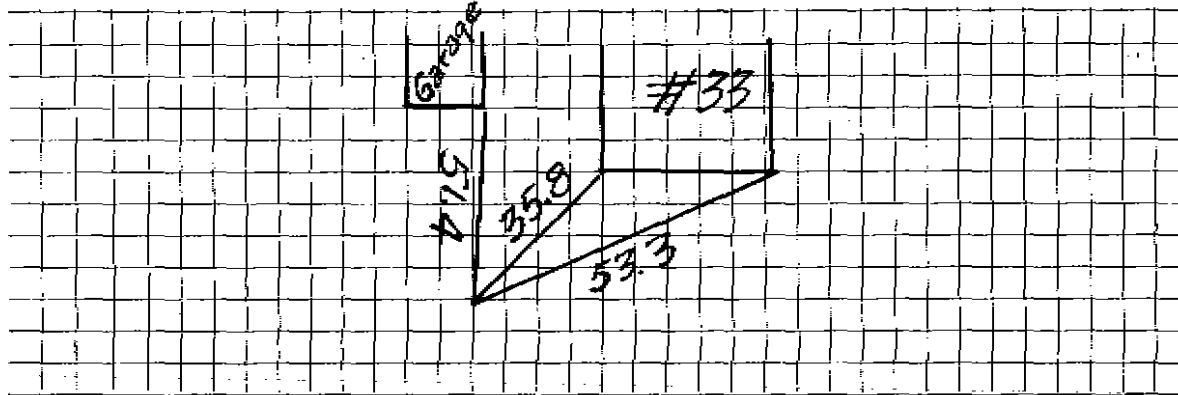

Connection made in _____ Street.

Work completed _____ 19

Remarks:



TOWN OF LEXINGTON
OFFICE OF SELECTMEN

5-8-07

Date

To *Douglas Morgan / Cynthia Sicker*

Under Article 6 section 2 of the General By-Laws of the Town of Lexington, it is ordered that "The Selectmen shall determine and designate numbers for the buildings abutting upon or adjacent to such streets or portions of streets as they may deem best for public convenience. No person shall neglect or refuse to affix to any building owned by him, the street number designated for him by said board."

The owner of the building on

33 BLAKE RD.

Street

71/279

Lot No.

is hereby notified that
the proper number is

2 NOWERS RD.

BOARD OF SELECTMEN

By

Peter Karalakis