

Builder:

Name **Thomas E. Moone, Jr.** Owner- **F.B. Merson**

Service No. ~~150~~ **287**

Address **1 Cook Terrace, Woburn, Mass.**

#**6547**

36 Blake Road

Location **36 Blake Road.**

Kind of Pipe

Size

Size of Main

Repair—Renewal—New Service

Location

Date 1941	Material	Amount	Total	Date	Amount
Dec. 10	3 hrs. @ 60¢	1 80			
<i>Com 12/22/41</i>	10% Overhead	18	1 98	<i>Dec. 6th 1941</i>	<i>25.00</i>
	78' 3/4" C. Tubing @ 19¢		14 82	<i>Dec 30. 1941</i>	<i>3 95</i>
	1 3/4" C. x 1/8" I.S. & W.		2 50		<i>Refund</i>
	1 3/4" C. Union (3 parts)		1 00		
	1 hr. trucking @ 75¢		75		
			21 05		<i>21 05</i>
	Labor				

Bradley Press, Inc., Lexington

DATE Dec 5 1941

TOWN OF LEXINGTON—BOARD OF PUBLIC WORKS

WATER DIVISION

The undersigned applies for a supply of water at No. 36 Blake Rd St. and hereby agrees to comply with the rules and regulations as now, or at any future time, established by the Board of Selectmen.


Am't. of Estimate \$ 25.00

Am't. Paid \$ _____

Builder Moore Construction Co

Builder
Owner Thomas E Moore Jr
Address 1 Cook Terrace Watervt
Owner F. E. Nelson

Sketch of Service Here

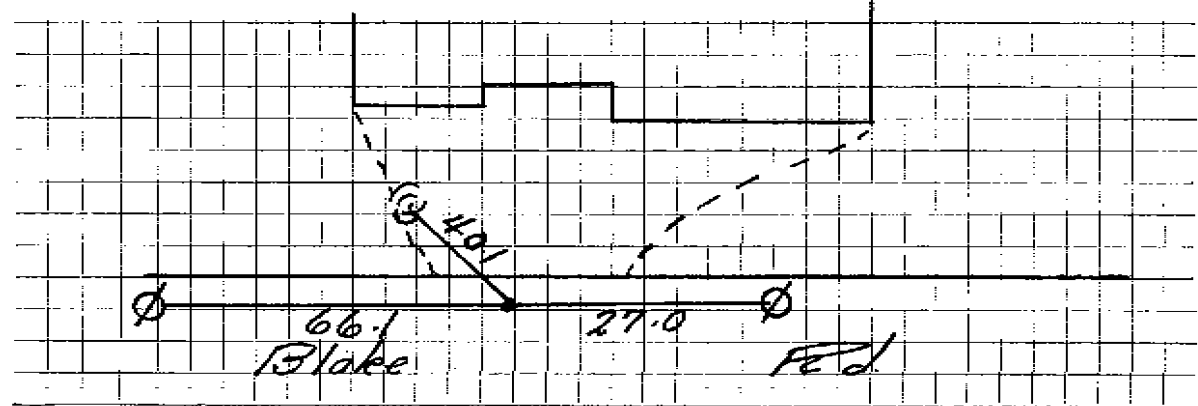

Connection made in _____ Street. Work completed _____ 19

Remarks: