

WATER SERVICE RECORD

#5670

Name Henry B. Shea

Service No. 5

Address 39 Blake Road

Location Lexington, Mass.

~~Repair & Renewal~~ - New Service


Com. 2-19-51

Date	Material	Amount	Total	Date	Amount
1-15-51	Labor	3 85	3 85	Jan 15 51	53 25
	10% Overhead		39	April 10 51	8 47
	64' - 3/4" Copper Tubing @.34	21 76			No Charge
	1 - 3/4" x 1/2" I.W.H. S&W	4 00		1 - 15-51	Labor
	1 - 3/4" x 3/4" Union (3pts)	1 72			21' - 3/4" Copper Tubing @.34
	Littlefield Shovel 3 hrs. @7.00	21 00			1 - 3/4" Corp-cock
	Trucking 1 hr. @.75	75			1 - 3/4" x 3/4" Curt-cock
			53 47		1 - Box & Rod
					1 - 1/2" Offset Tail Piece
					1 - 1/2" Straight Tail Piece
					Littlefield Shovel 2 2/3 hrs.
					Trucking 1 hr. @.75
					48 15

DATE \_\_\_\_\_

TOWN OF LEXINGTON — BOARD OF PUBLIC WORKS  
WATER DIVISION

Sketch of Service Here

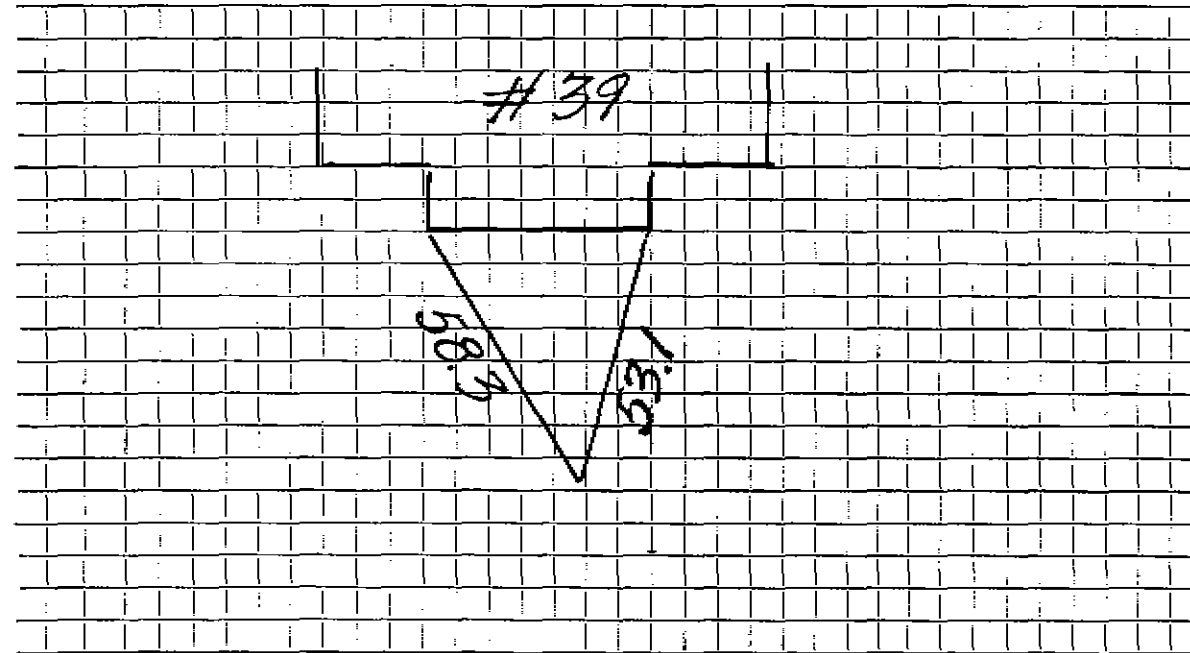

Connection made in ..... Street.      Work completed .....

Remarks: .....

.....  
.....