

Name Hallie C. Blake
4 Blake Rd
 Address 374 Washington St., Boston

Service No. # 286

Location 4 Blake Avenue

Kind of Pipe

Size

Size of Main

Repair—Renewal—New Service

Location

Date	Material	Amount	Total	Date	Amount
8/14 -19 <i>Comp. 25.26 to Hessell 11/14</i>	18 hrs. @ 55¢	9 90		<i>Sept 18, 1930</i>	<i>Deposited</i>
	7 " @ 60¢	4 20			<i>25 26</i>
	10% Overhd. on labor	1 41			
	50' 3/4" Copper Tub. <i>@ 16¢</i>	8 00			
	1 3/4" S. & W.	1 75			
			25 26		
	Labor				

*Note: Part of amount on sewer acct is credited as
 payment on this acct. P.D.*

TOWN OF LEXINGTON—BOARD OF PUBLIC WORKS
WATER DIVISION

The undersigned applies for a supply of water at No. 4 Blake Ave. St. and hereby agrees to comply with the rules and regulations as now, or at any future time, established by the Board of Selectmen.

Am't. of Estimate \$ _____

Owner

Hallie & Beahm


Am't. Paid \$ _____

Address

50 Merriman St
Lexington

Builder _____

Sketch of Service Here

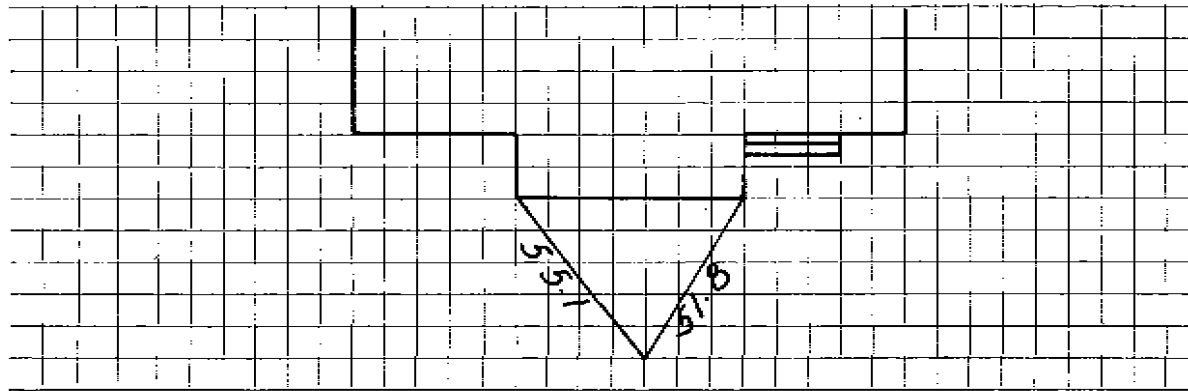

Connection made in _____ Street.

Work completed _____ 19

Remarks: