WATER SERVICE RECORD


Name Peter Farfaras				Service No.								
Ad	dress	40 Blake Road										
Lo	cation			orthern #3882								
Re	pair—R	enewał—New Service	Great Northern									
Dat	e	Material	Amount	Tetal	Date		Amount					
8/2/84	44'	1" Copper			#							
· · · · · · · · · · · · · · · · · · ·		l" Valve		 	ļ !	· 	· 					
			- · · · · · · · · · · · · · · · · · · ·		·	<u> </u>						
-	-{-	 			. !! 	OUTSIDE						
	! 	! 			8/2/84 13'	1" Copper						
		<u> </u>		 	' <u>'</u>	1" Corp						
	 -	· 										
	_ _			 	· 	Box & Rod	 					
				<u> </u>		<u></u>	!					
	<u> </u>	<u> </u>		 	- 							
	_ —			·	· · · · · · · · · · · · · · · · · · ·	<u> </u>	· · · · · · · · · · · · · · · · · · ·					
		' 				 						
	 _		— 	i -	·	: 						
				: 	<u> </u>	 						
		!	+	 		 						
· · 		 		<u> </u>	#		_					
	 - 		- - - -	 		! 						
		,	·- - - ·- - ·-			ļ						
	ı	I .	I .	I	, II	1	_ <u>-</u> 1					

n.	AT	F						
_		_	 	 	_	 	_	

TOWN OF LEXINGTON - BOARD OF PUBLIC WORKS

WATER DIVISION

Sketch of Service Here

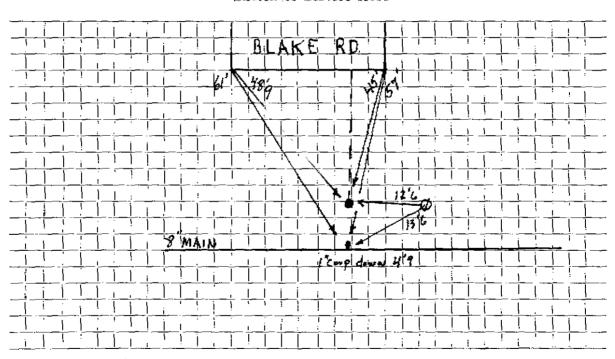

Connection made in	. Street.	Work completed
Remarks:		
	• • • • • • • • • • • • • • • • • • • •	