

Name ~~John E. Clark~~, Builder

Service No. ~~58~~ 288

Address ~~22 Prescott Street, Medford~~
48 Blake Road

6123

Location 48 Blake Road

Kind of Pipe

Size

Size of Main

~~Repair~~ ~~Renewal~~ — New Service

Location

Date
1941

Material

Amount

Total

Date

Amount

June 26

4 hrs. @ 60¢

2 40

10% Overhead

24

2 64

45' 3/4" Copper tubing

1 90

3 55

1 3/4" C. & G. 1.5 @ 17.

2 25

3 hrs. trucking @ 75¢

2 25

15 69

June 24, 1941 Repeated
August 24, 1941 Repeated

20 80

4 31

15 69

Labor

DATE - 41

TOWN OF LEXINGTON — BOARD OF PUBLIC WORKS

WATER DIVISION

The undersigned applies for a supply of water at No. 48 Blake Rd and hereby agrees to comply with the rules and regulations as now, or at any future time, established by the Board of Selectmen.

Am't. of Estimate \$ 20.00

Owner

Dezter P. Fisher


Am't. Paid \$

Address

40 Essex Rd
Milton Mass

Builder

Sketch of Service Here

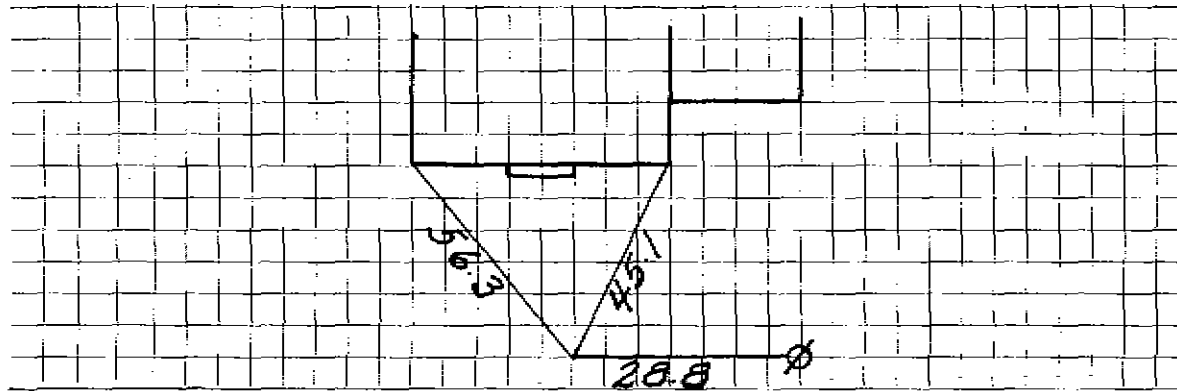

Connection made in _____ Street.

Work completed _____ 19

Remarks: