

Name Walter G. Black

Service No. ³²¹~~58~~ 289

Address ~~11 Highland Ave.,~~
51 Blake Road

Location 51 Blake Road

Kind of Pipe

Size

Size of Main

Repair—Renewal—New Service

Location

Date
1941

Material

Amount

Total

Date

Amount

June 20

4 hrs. @ 60¢ 2 40

10% Overhead 24

51' 3/4" Copper tubing @ 19¢ 9 39

1 3/4" C.S. W. 2 25

1 3/4" Flushing 25

3 hrs. trucking @ 75 2 25

17 00

June 19, 1941 Deposited
August 20, 1941 Returned

25 00
192
17 08

Labor

DATE 6/19 41

TOWN OF LEXINGTON—BOARD OF PUBLIC WORKS

WATER DIVISION

The undersigned applies for a supply of water at No. 51 Blake Road and hereby agrees to comply with the rules and regulations as now, or at any future time, established by the Board of Selectmen.

Am't. of Estimate \$ _____

Owner J C Bartlett


Am't. Paid \$ 25 ⁰⁰/₁₀₀

Address 51 Blake Road

Builder A S Blad

Lexington

Sketch of Service Here

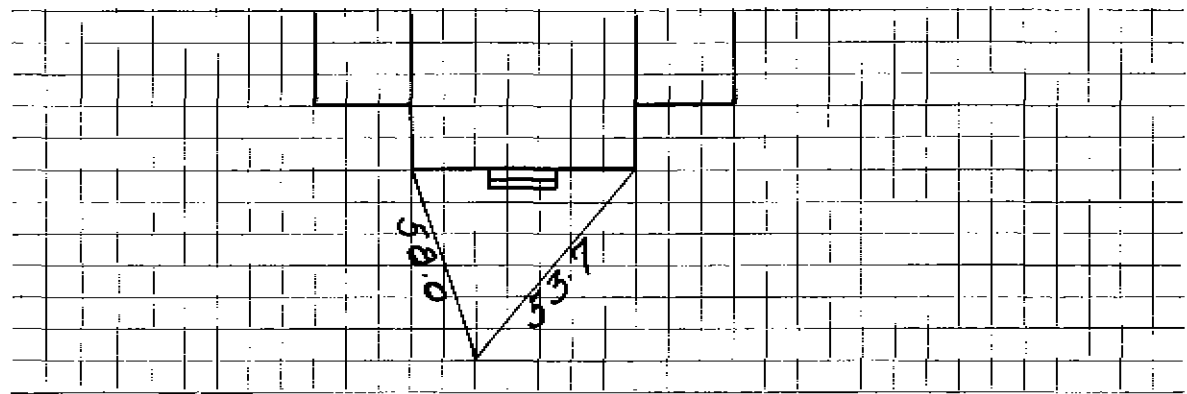

Connection made in _____ Street.

Work completed _____ 19

Remarks: