

Name John Callahan
 Address 54 Blake Road
 Lexington, Mass.

Service No.

525
2048

Location

Kind of Pipe

Size

Size of Main

~~Repair~~ ~~Renewal~~ New Service

Location

Date	Material	Amount	Total	Date	Amount
Oct. 11, '48	Labor	1 05	1 05	<i>Sept. 28, '48</i>	<i>50.00</i>
" 12 "	" "	1 25	1 25	<i>Jan. 21 '46</i>	<i>21.15</i>
	10% Overhead		23		<i>31.14</i>
	42'-3/4" Copper Tubing @ .255	10 71	10 71	Oct. 12, '48	Labor 4 63
	1-3/4" C x 1/2" I.W.H. S&W	3 15	3 15	12'-3/4" Copper Tubing @ .255	3 06
	2 hrs. Littlefield Shovel	14 00	14 00	1-3/4" C. Corp-cock	3 00
	1 hr. Trucking		75	1-3/4" C x 3/4" C. Curb-cock	3 68
			31 14	1-Box & Rod	3 55
				1 hr. Littlefield Shovel	7 00
				1-1/2" Offset Tail Piece	30
				1-1/2" Straight Tail Piece	30
				1 hr. Trucking	75
	Labor				<u>26 27</u>

TOWN OF LEXINGTON - BOARD OF PUBLIC WORKS

WATER DIVISION

The undersigned applies for a supply of water at No..... St. and hereby agrees to comply with the rules and regulations as now, or at any future time, established by the Board of Selectmen.

Am't of Estimate \$.....


Owner

Am't Paid \$.....

Address

Builder

Sketch of Service Here

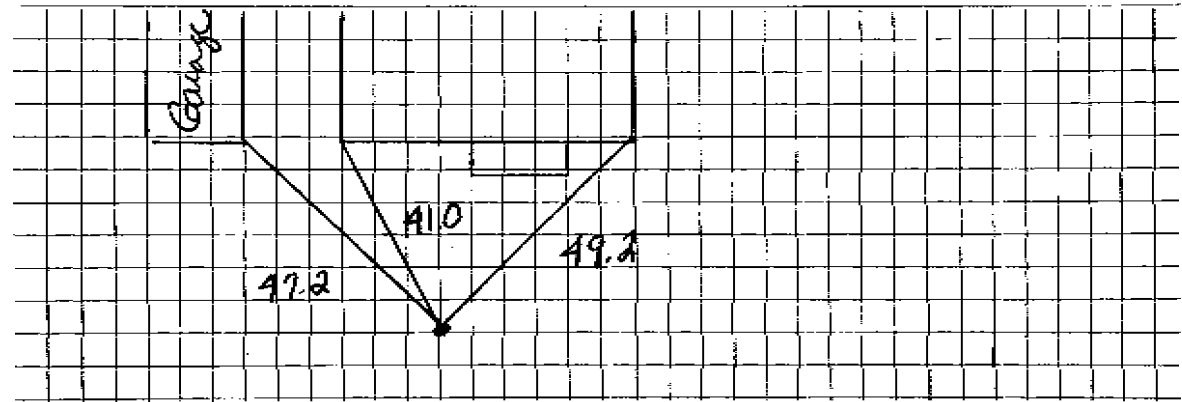

Connection made in Street.

Work completed19

Remarks: