

Check from
 Name **Builder:** Walter G. Black
 Address ~~11 Highland Ave.,~~
 57 Blake Rd.

Owner:
 Otis A. Ward
 124 Walker Street
 Cambridge, Mass.

Service No. ~~27~~ 290
 # 2066

Location 57 Blake Road

Kind of Pipe Size Size of Main

~~REPAIR EXISTING~~ - New Service

Location

| Date | Material | Amount | Total | Date | Amount |
|-------------------------------|------------------------------|--------|-------|---------------|--------|
| 1940 | | | | | |
| June 27, <i>Com 7/8/40</i> | 2 hrs. @ 60¢ | 1 20 | | June 27, 1940 | 35 00 |
| | 10% Overhead | 12 | 1 32 | July 11, 1940 | 5 70 |
| | 77' 3/4" Copper tubing @ 18¢ | | 13 86 | | 29 30 |
| | 1 3/4" C. Corp. cock | | 2 30 | | |
| | 1 3/4" C. Curb cock | | 2 50 | | |
| | 1 3/4" CcI S. & W. | | 2 25 | | |
| | 1 Box & Rod | | 1 82 | | |
| | Construction charge | | 3 75 | | |
| | | | 27 80 | | |
| | 2 hrs. trucking @ 75¢ | | 1 50 | | |
| | | | 29 30 | | |
| | Labor | | | | |

Hadley Press, Inc., Lexington

DATE July 1, 1940

TOWN OF LEXINGTON—BOARD OF PUBLIC WORKS

WATER DIVISION

The undersigned applies for a supply of water at No. 57 Blake Road St and hereby agrees to comply with the rules and regulations as now, or at any future time, established by the Board of Selectmen.

Am't. of Estimate \$ 35⁰⁰

Owner Wes A. Ward


Am't. Paid \$ 35⁰⁰

Address 124 Walker St

Builder H. S. Black

Cambridge Mass

Sketch of Service Here

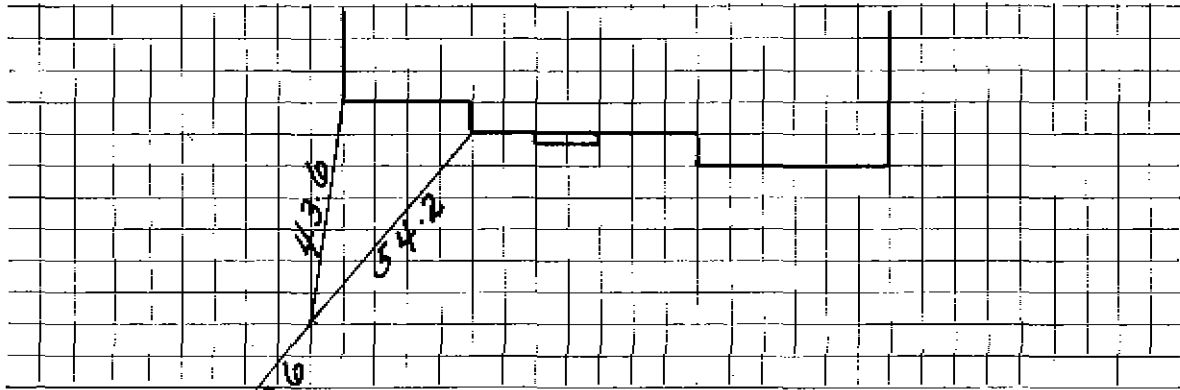

Connection made in _____ Street. Work completed _____ 19

Remarks: