

Check from:

Name Walter G. Black (Builder) Mrs. John P. Dailey, Owner

1437

Service No. ~~28~~ 291

Address ~~11 Highland Avenue, Lexington~~
58 Blake Road

Location 58 Blake Road

Kind of Pipe

Size

Size of Main

~~Repair - Renewal~~ New Service

Location

Date
1941

Material

Amount

Total

Date

Amount

May 7

5 hrs. @ 60¢

3 00

May 5, 1941

Deposited

25 00

from 6/9/41

10% Overhead

30

3 30

June 17, 1941

Refunded

1 25

50' 3/4" Copper tubing @ 19¢

9 50

23 25

1 3/4" C. Corp. cock

2 25

1 3/4" C. Curb cock

2 75

1 3/4" C. x 1/2" I.S. & W.

2 25

1 Box & rod

1 70

Trucking - 2 hrs. @ 75¢

1 50

23 25

Labor

Hadley Press, Inc., Lexington

DATE May 2, 1941

TOWN OF LEXINGTON—BOARD OF PUBLIC WORKS

WATER DIVISION


The undersigned applies for a supply of water at No. 58 Blake Road St. and hereby agrees to comply with the rules and regulations as now, or at any future time, established by the Board of Selectmen.

Am't. of Estimate \$ 25-00 ^{per estimate} Miss Owner Margaret Wailey

Am't. Paid \$ _____ Address 58 Blake Road
Lexington

Builder A. S. Black

Sketch of Service Here

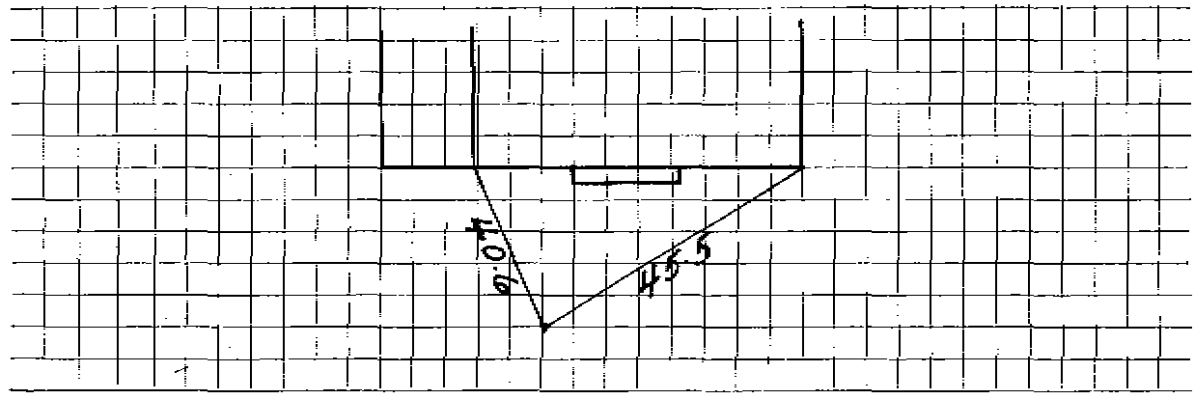

Connection made in _____ Street. Work completed _____ 19

Remarks: