

Name Gustave Larson

Service No.

Address 60 Blake Road

447

Lexington, Mass.

Location 60 Blake Road

Kind of Pipe Com. June 21, 1948

Size

Size of Main

~~Repair~~ Renewal - New Service

Location

Date	Material	Amount	Total	Date	Amount
May 14, '48	Labor	5 75	5 75	May 14, '48	35 00
	10% Overhead		58	June 24, '48	1 84
	35' - 3/4" Copper Tubing @ .255	8 93			33 16
	1 - 3/4" C x 1/2" I.W.H. S & W	3 15		May 14, '48	Labor
	Littlefield Shovel 2 hrs. @ 7.00	14 00			9 75
	Trucking 1 hr. @ .75	75			8' - 3/4" Copper Tubing @ .255
			33 16		2 04
					1 - 3/4" C Corp-cock
					3 00
					1 - 3/4" C x 3/4" C Curb-cock
					3 68
					1 - Box & Rod
					3 50
					1 - 1/2" Straight Tail Piece
					30
					1 - 1/2" Offset Tail Piece
					30
					Littlefield Shovel 2 hrs. @ 7.00
					14 00
					Trucking 1 hr. @ .75
					75
	Labor				37 32

Deposited
Refunded
Non-Charge

Hadley Press, Inc., Lexington

DATE _____

TOWN OF LEXINGTON—BOARD OF PUBLIC WORKS

WATER DIVISION

The undersigned applies for a supply of water at No. _____ St. and hereby agrees to comply with the rules and regulations as now, or at any future time, established by the Board of Selectmen.

Am't. of Estimate \$ _____


Owner _____

Am't. Paid \$ _____

Address _____

Builder _____

Sketch of Service Here

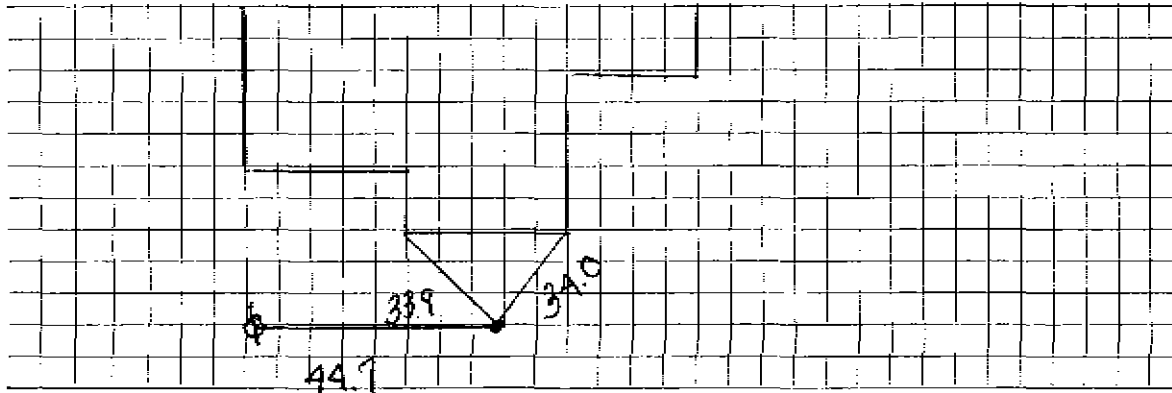

Connection made in _____ Street.

Work completed _____ 19

Remarks: