


TOWN OF LEXINGTON — BOARD OF PUBLIC WORKS
WATER DIVISION

Sketch of Service Here

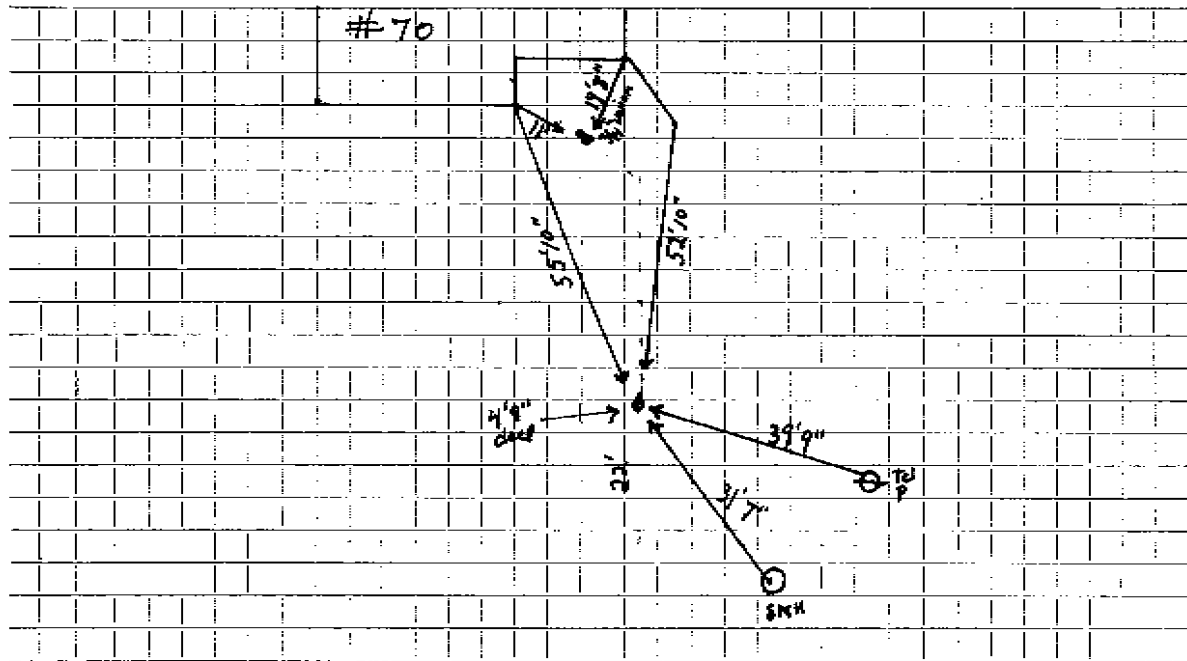

Connection made in *Blake rd.* Permit *3627* Street. Work completed *12-13-10*

Remarks:

.....

.....