

Check from:

Name C.J. Jenney (Builder) H. Carpenter (Owner)

Service No. ~~78~~ 295

Address ~~23 Everett Street, Concord, Mass~~

80 Blake Road

Cor. Blake and

Location

Preston Roads (80 Blake Rd.)

Kind of Pipe

Size

Size of Main

Repair—Renewal—New Service

Location

Date
1939

Material

Amount

Total

Date

Amount

Dec. 9

2 hrs. @ 60¢

1 20

November 23, 1939 Deposited

35 00

Com. 11.26.39

2 " @ 65¢

1 30

2 50

December 28, 1939 Refund

11 21

10% Over-head

25

23 79

64' 3/4" Copper Tubing @ 16¢

10 24

1 3/4" C. Corp. cock

2 15

1 3/4" C. Curb Cock

2 00

1 3/4" C. x I S. & W.

2 10

2 1/2" Straight Tail Pieces @ 60¢

1 20

1 Box & rod

1 85

2 hrs. trucking @ 75¢

1 50

25 79

Labor

DATE Nov. 20, 1939

TOWN OF LEXINGTON—BOARD OF PUBLIC WORKS

WATER DIVISION

car Blakes.

The undersigned applies for a supply of water at No. 80 ~~East~~ ^{Blair} St. and hereby agrees to comply with the rules and regulations as now, or at any future time, established by the Board of Selectmen.

Am't. of Estimate \$ 35⁰⁰

Owner H. Carpenter


Am't. Paid \$ _____

Address Cambridge Mass.

Builder C. J. Jenney, 23 Everett St
Cambr. (Conn.)

By C. J. Jenney, 23 Everett St
Cambr. Mass.

Sketch of Service Here

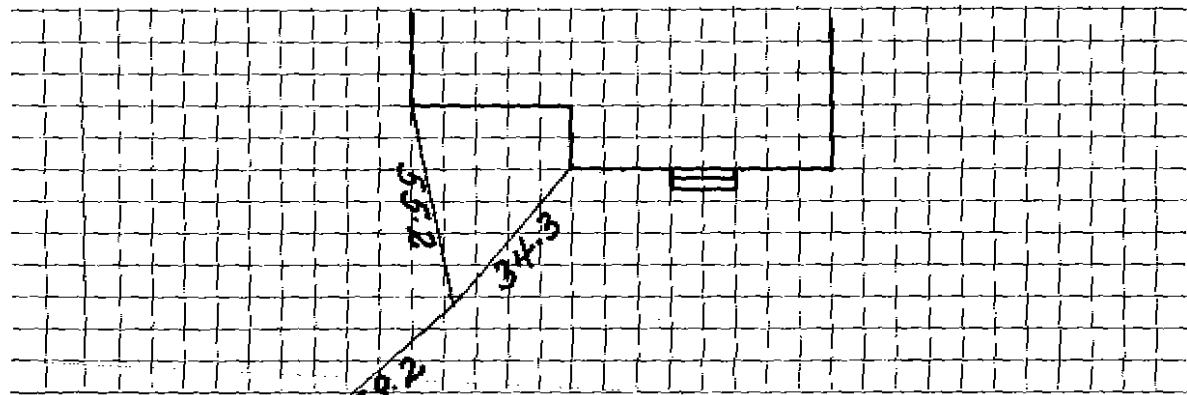

Connection made in _____ Street.

Work completed _____ 19

Remarks: