

Name Arthur Mitchell

Service No. 149

Address 90 Blake Road

#5911

Lexington, Mass.

Location

90 Blake Road

Kind of Pipe

Size

Size of Main

Repair - Renewal - New Service

Com. 8-23-48

Location

Date	Material	Amount	Total	Date	Amount
Oct. 20, '47	Labor	8 40	8 40	Oct 17 '47	30 00
	10% Overhead		84	Aug 20 '48	8 36
	44' - 3/4" Copper Tubing @.255	11 22			<u>38 36</u>
	1 - 3/4" C x 1/2" I.W.H. S & W	3 15			Non-Charge
	Shovel 2 hrs. @ 7.00	14 00		Oct. 20, '47	Labor
	Trucking 1 hr. @ .75	75			7 73
			38 36		12' - 3/4" Copper Tubing @.255
					3 06
					1 - 3/4" C Corp-cock
					3 00
					1 - 3/4" C x 3/4" C Curb-cock
					3 68
					1 - Box & Rod
					3 55
					1 - 1/2" Offset Tail Piece
					30
					1 - 1/2" Straight Tail Piece
					30
					Trucking 1 hr. @.75
					<u>75</u>
					22 37
	Labor				

Hadley Irons, Inc., Lexington

~~12265~~ ~~RoE~~

DATE _____

TOWN OF LEXINGTON—BOARD OF PUBLIC WORKS

WATER DIVISION

The undersigned applies for a supply of water at No. _____ St. and hereby agrees to comply with the rules and regulations as now, or at any future time, established by the Board of Selectmen.

Am't. of Estimate \$ _____


Owner _____

Am't. Paid \$ _____

Address _____

Builder _____

Sketch of Service Here

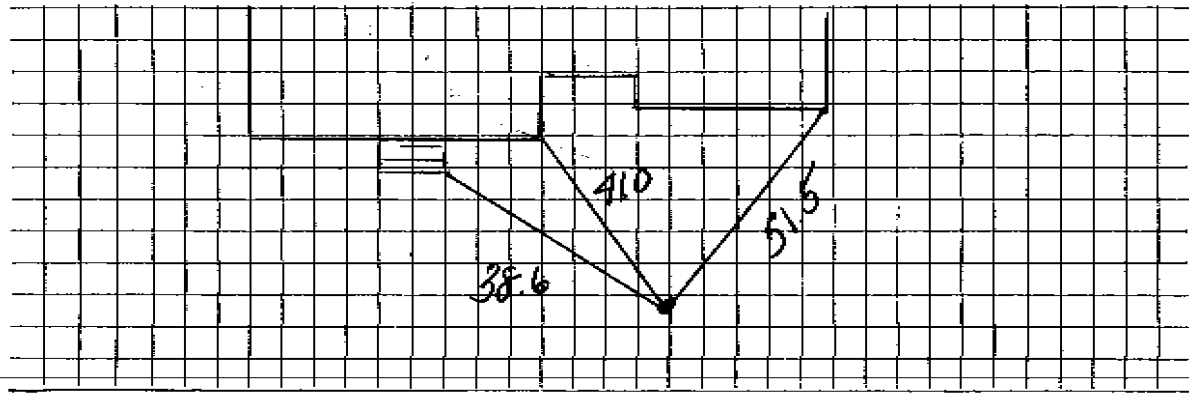

Connection made in _____

Street.

Work completed _____ 19

Remarks: