

Name Daniel P. Wilson

Service No. ~~296~~ 296

Address ~~18 Bacon Road, Bedford, Mass.~~

91 Blake Road

# 6966

Location

Lot 15, Blake Road. #91

Kind of Pipe

Size

Size of Main

Repair—Renewal—New Service

Location

Date

Material

Amount

Total

Date

Amount

5/4/40

28 1/2 hrs. @ 55¢

15 68

Com 7/20/40

30 " @ 60¢

18 00

10% Overhead

33 68

3 37

63' 1" copper tubing @ 19¢

11 97

1 1" copper corp. cock

3 71

1 1" " curb cock

3 80

1 1" C " x 3/4" I S. & W.

2 25

1 box and rod

1 81

Trucking 2 hrs. @ 75¢

1 50

\$62 09

May 3, 1940 Deposited

60.00

NOTE: Say \$60.00

Labor

DATE April 12/40

# TOWN OF LEXINGTON—BOARD OF PUBLIC WORKS

## WATER DIVISION *Lot 15, 14-13 etc.*

The undersigned applies for a supply of water at No. Blake Rd. St. and hereby agrees to comply with the rules and regulations as now, or at any future time, established by the Board of Selectmen.

Am't. of Estimate \$ 60<sup>00</sup>


Owner David P. Wilson

Am't. Paid \$ \_\_\_\_\_

Address 17 Bacon Rd  
Bedford Mass

Builder Faber C. Crocker

Sketch of Service Here

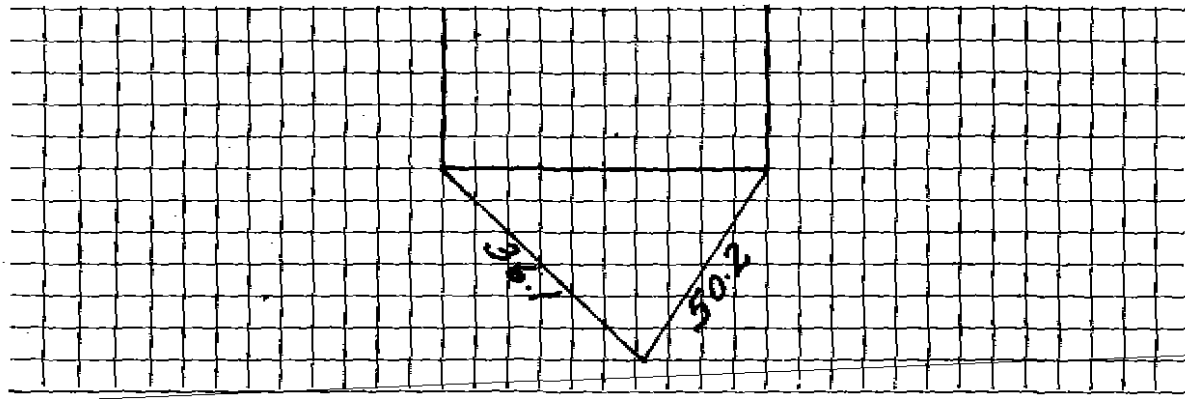

Connection made in \_\_\_\_\_ Street. Work completed \_\_\_\_\_ 19

Remarks: