

Check From Name **Joseph W. Farrell (Owner- M. Murray)**

Service No. **96 298**

Address ~~120 Grant Ave., Medford~~

~~96 Blake Road, Lexington~~

96 Blake Road

Location **96 Blake Road. Lexington**

Kind of Pipe

Size

Size of Main

Repair—Renewal—New Service

Location

Date	Material	Amount	Total	Date	Amount
Dec. 17, 1940	4 hrs. @ 60¢	2 40		December 17, 1940 Deposited	18 50
<i>Jan 17, 31, 40</i>	10% Overhead	24	2 64	<i>Dec 31, 1940</i> Refund	508
	37' 3/4" Copper tubing @ 19¢		7 03		13 47
	1 3/4" C.S/ & W.		2 25		
	2 hrs. trucking @ 75¢		1 50		
			13 42		
	Labor				

Hadley Press, Inc., Lexington

DATE _____

TOWN OF LEXINGTON—BOARD OF PUBLIC WORKS

WATER DIVISION

The undersigned applies for a supply of water at No. _____ St. and hereby agrees to comply with the rules and regulations as now, or at any future time, established by the Board of Selectmen.

Am't. of Estimate \$ _____


Owner _____

Am't. Paid \$ _____

Address _____

Builder _____

Sketch of Service Here

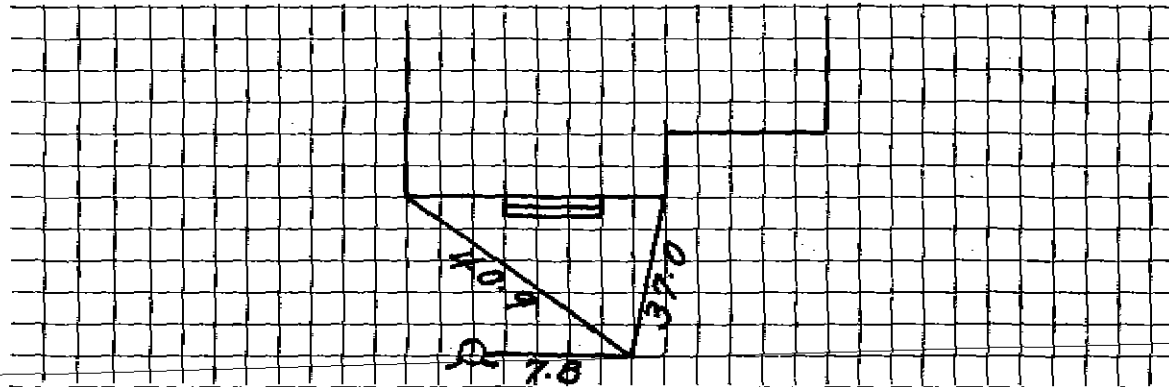

Connection made in _____ Street.

Work completed _____ 19

Remarks: