

Name Charles P. Ferguson

Service No. ~~# 298~~

Address ~~88 Highland Ave.~~

2645

5996

97 Blake Road

Location

97 Blake Road

Lots 16 & 17, Block 12, Lexington Manor

Kind of Pipe

Size

Size of Main

~~Repair - Renewal~~ - New Service

Location

Date	Material	Amount	Total	Date	Amount
8/9/34	36' 1" C. Pipe @.20	7 20			
⁹⁻²⁵⁻³⁴ Russell-36	1 S & W Trucking	2 75			
		75	\$10 70		
	35 Hrs. Labor @.55	19 25			
	3 " " @.60	1 80	21 05		
	10% Overhead		2 11		
	COST		\$33 86		
	CHARGE 36' @ \$1.00	\$36 00	\$36 00		
	Labor				
Sept. 25 1934	Refund				
			37 -		

Aug. 29 1934 - Deposit

37 -

37 -

Hadley Press, Inc., Lexington

37'

DATE Aug. 29, 1934

TOWN OF LEXINGTON—BOARD OF PUBLIC WORKS

WATER DIVISION

The undersigned applies for a supply of water at No. ^{Lots} 16 & 17, ^{Block 12} Blake Rd St. and hereby agrees to comply with the rules and regulations as now, or at any future time, established by the Board of Selectmen.

Am't. of Estimate \$ 37.


Owner Charles E. Ferguson

Am't. Paid \$ 37.

Address 28 Highland Ave.
Lexington.

Builder _____

Sketch of Service Here

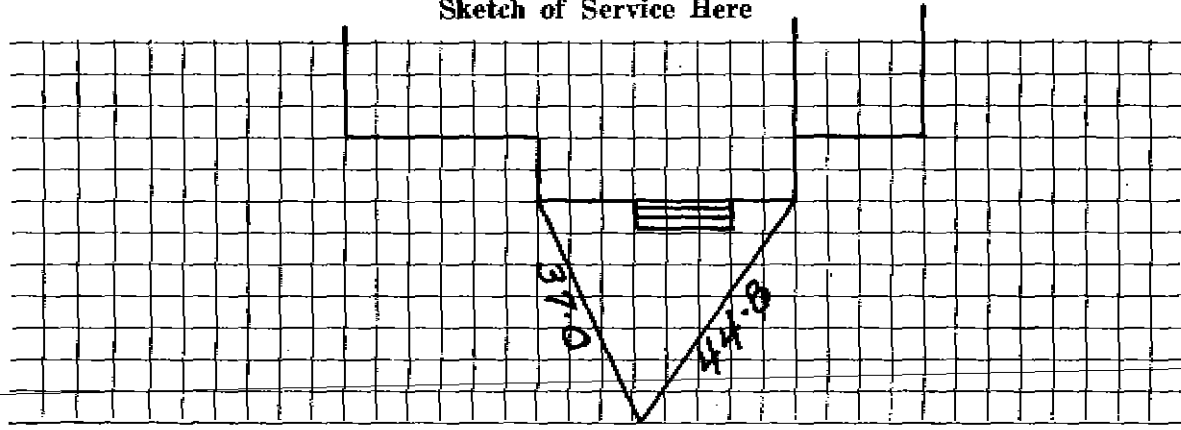

Connection made in _____ Street.

Work completed _____ 19

Remarks: