




DATE 3/9/2020

TOWN OF LEXINGTON — BOARD OF PUBLIC WORKS

WATER DIVISION

Sketch of Service Here

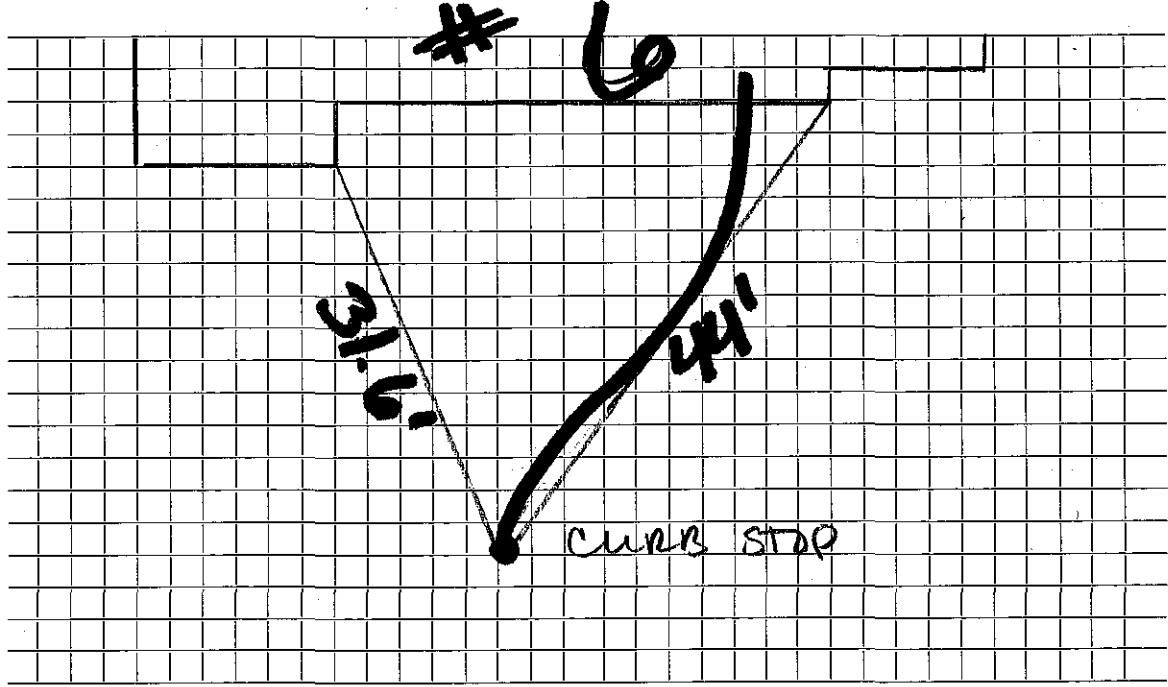

Connection made in Blinn Rd Street. Work completed .....

Remarks: .....