

WATER SERVICE RECORD

Name ~~Rock~~ Ouhet Realty Trust

Service No. 217

Address # 10 Blodgett Rd.

Location Lot # 5

~~Water~~ ~~Service~~ - New Service

Comm 11-16-59

Date	Material	Amount	Total	Date	Amount
9-9-59	Labor	2 14		9-9-59	35 80
	10% O. H.	21	2 35	11-16-59	3 77
	55' 3/4" Copper tubing @.41		22 25		31 23
	1 3/4" C x 1/2 I.W.H. Stop & Waste	5 88			NON CHARGE
	1 Hr. Trucking		75	5/18/57	Labor
			31 23		5 98
				26' - 3/4" Copper tubing	9 75
				1 3/4" " C. Corp Cock	4 64
				1 3/4" " C Curb Cock	5 94
				1 Box & Rod	4 62
					30 93
				9-9-59 1 1/2 Straight Tailpiece	50
				1 1/2 Offset Tailpiece	50
					31 93


* Apply (1991) to W.H.H. 1815

DATE _____

TOWN OF LEXINGTON — BOARD OF PUBLIC WORKS

WATER DIVISION

Sketch of Service Here

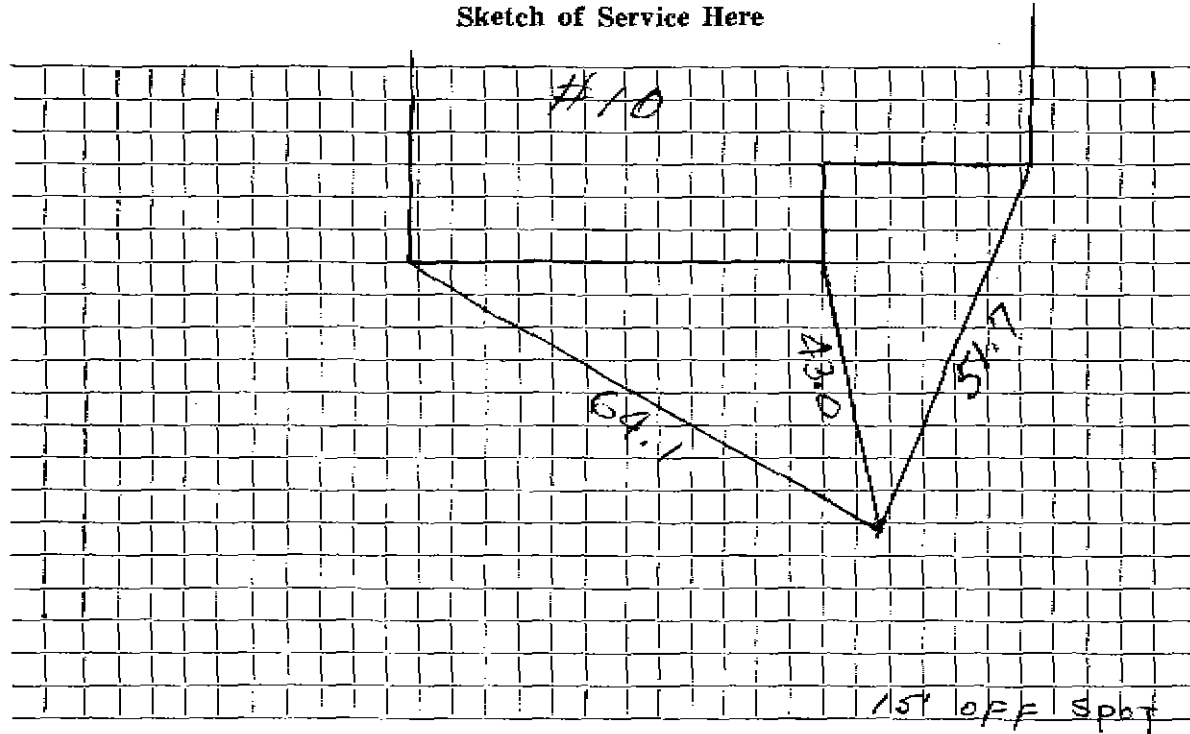

Connection made in Street. Work completed

Remarks:
.....
.....