

WATER SERVICE RECORD

Name Outhet Realty Trust

Service No. 94

Address #3 Blodgett Rd.

Location Lot #23

~~Right of Way~~ - New Service

Comm. 9/30/57


| Date | Material | Amount | Total | Date | Amount |
|-------------|------------------------------------|--------|-------|-------------|-------------------------------|
| May 18, '57 | Labor | 10.35 | | 5-20-57 | Deposit #35.00 |
| | 10% O.H. | 1.04 | 11.39 | 10-18-57 | Pd. by Ref. on W.H.C. #68 |
| | 45' 3/4" Copper tubing @.4228 | | 19.03 | | #36.13 |
| | 1 3/4" C x 1/2 I.W.H. stop & waste | | 4.96 | May 18, '57 | Labor |
| | 1 hr. trucking @.75 | | .75 | | 2.76 |
| | | | 36.13 | | 12' 3/4" Copper tubing @.4228 |
| | | | | | 5.07 |
| | | | | | 1 3/4" C. Corp. Cock |
| | | | | | 4.64 |
| | | | | | 1 3/4" C. Cock Curb |
| | | | | | 5.94 |
| | | | | | 1 Bbx & Rod |
| | | | | | 4.62 |
| | | | | | 1 1/2 Straight tail piece |
| | | | | | .50 |
| | | | | | 1 1/2 Offset tail piece |
| | | | | | .50 |
| | | | | | 24.03 |

DATE _____

TOWN OF LEXINGTON — BOARD OF PUBLIC WORKS

WATER DIVISION

Sketch of Service Here

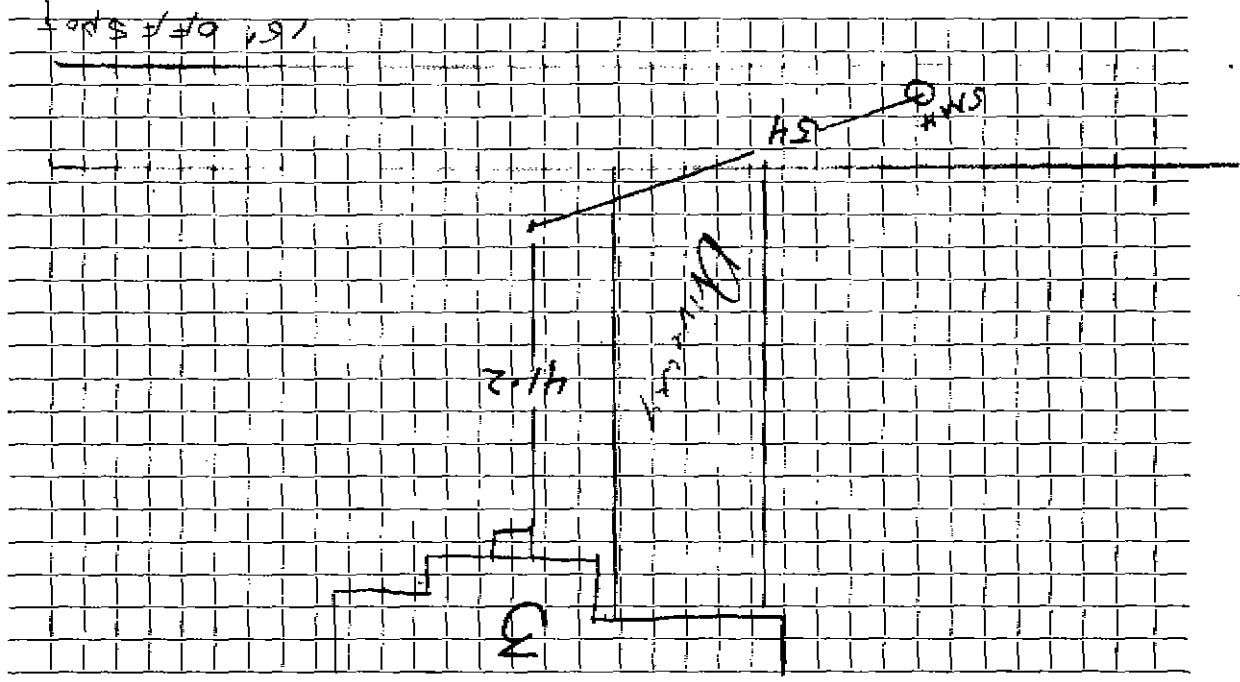

Connection made in _____

Street _____

Work completed _____

Remarks: _____