

WATER SERVICE RECORD

Name Woburn Hardware & Plumbing Supplies

Service No. 138

Address #4 Blodgett Rd.

Location

Lot # 2

~~Repair - Extension~~ New Service

Service was in

Comm 11-17-58


Date	Material	Amount	Total	Date	Amount	
7-21/58	Labor	21 81		7-12-58	Deposit	100 00
	10% overhead	2 18	23 99	11-17-58	Retained	28 75
	70'-3/4" copper tubing @.37		25 90		NON CHARGE	21 25
	1-3/4" Cx 1/2 I.W.H. stop & waste	5 84		5/18/57	Labor	5 75
	1-3/4" C-3 part union		2 27		25' - 3/4" Copper tubing	9 38
	1 hr. Town Shovel @ 6.50		6 50	1 3/4"	C. Corp Cook	4 64
	1 hr. trucking @ 3.00		3 00	1 3/4"	C Curb Cook	5 94
	1 hr. trucking @.75		75	1	Box & Rod	4 62
	1 hr. Rodgers Trailer @ 3.00		3 00			30 33
			71 25	1-1/2" straight piece		50
				1-1/2" offset tail piece	7/21/58	50
						31 33

DATE _____

TOWN OF LEXINGTON — BOARD OF PUBLIC WORKS

WATER DIVISION

Sketch of Service Here

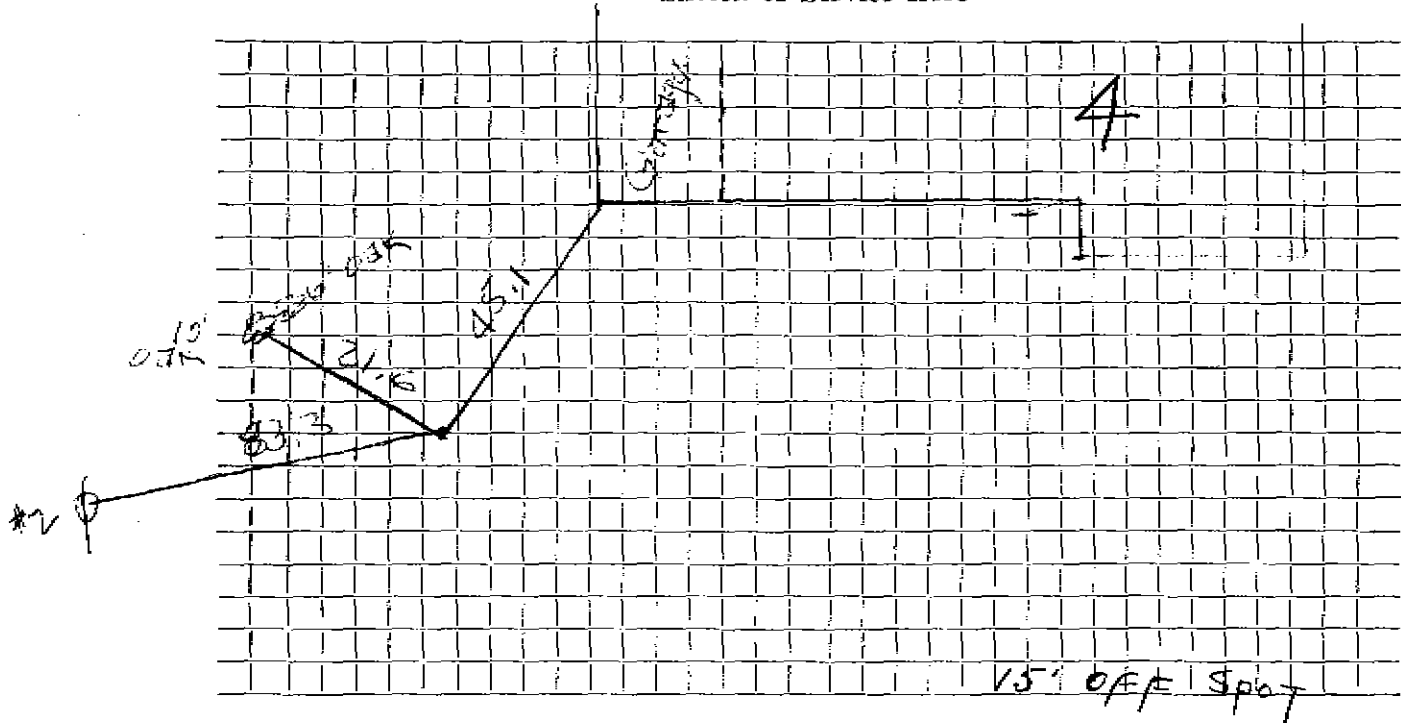

Connection made in Street. Work completed

Remarks:

.....

.....