


DATE _____

TOWN OF LEXINGTON — BOARD OF PUBLIC WORKS
WATER DIVISION

Sketch of Service Here

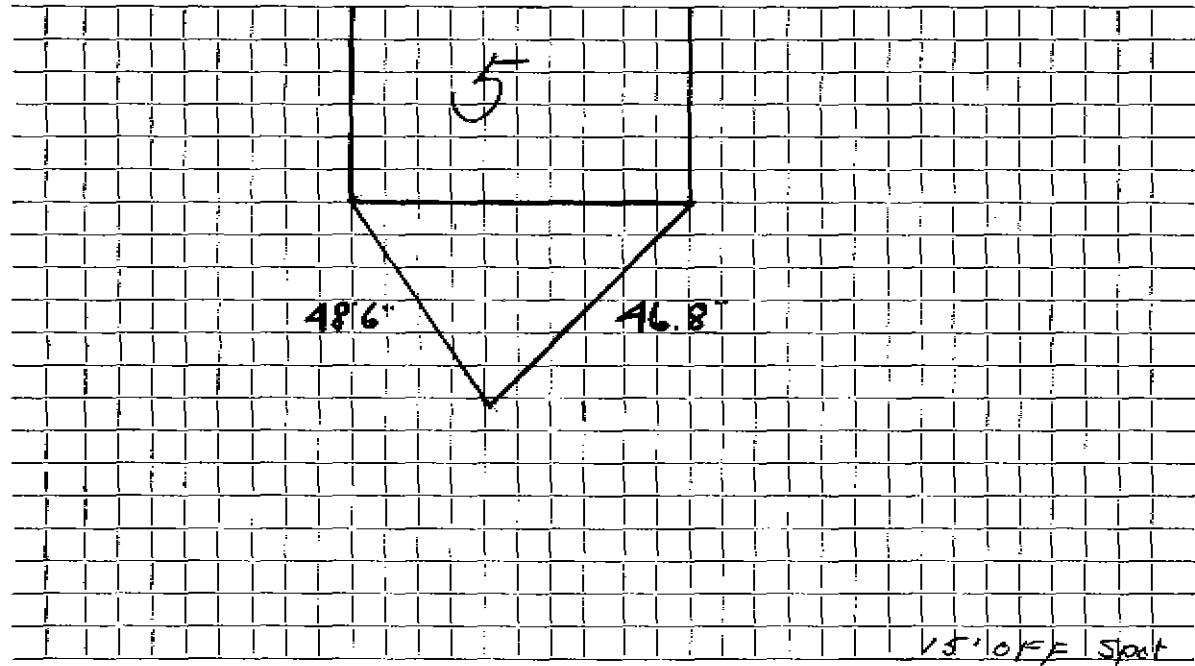

15' OFF Spot

Connection made in Street. Work completed

Remarks:
.....
.....