

WATER SERVICE RECORD

Name Raymond F. BoudreauService No. 85Address # 7 Blodgett Rd.Location Lot 21

Repair—Renewal—New Service

Jan 11-14-58


Date	Material	Amount	Total	Date	Amount
5/22/58	Labor	21 53			
	10% Overhead	2 15	23 68		
	58' 3/4" Copper Tubing @ 37		21 46	11-14-58	Deposit 100 00
	1 3/4" Cx 1/2 IWH Stop & Waste		5 84		Refund 38 27
	1 Hr Town Shovel @ 6.50		6.50	5/18/57	NON CHARGE 61 23
	1 Hr Trucking @ 75		75		Labor 4 37
	1 Hr Allis Chalmers @ 3.00		3 00		19' - 3/4" Copper tubing 7 13
			23		1 3/4" C. Corp Cock 4 64
					1 3/4" C Gurb Cock 5 94
					1 Box & Rod 4 62
					26 70
					1 1/2 Offset Tail Piece 50
					1 1/2 Straight Tail Piece 50
					27 70

DATE _____

TOWN OF LEXINGTON — BOARD OF PUBLIC WORKS

WATER DIVISION

Sketch of Service Here

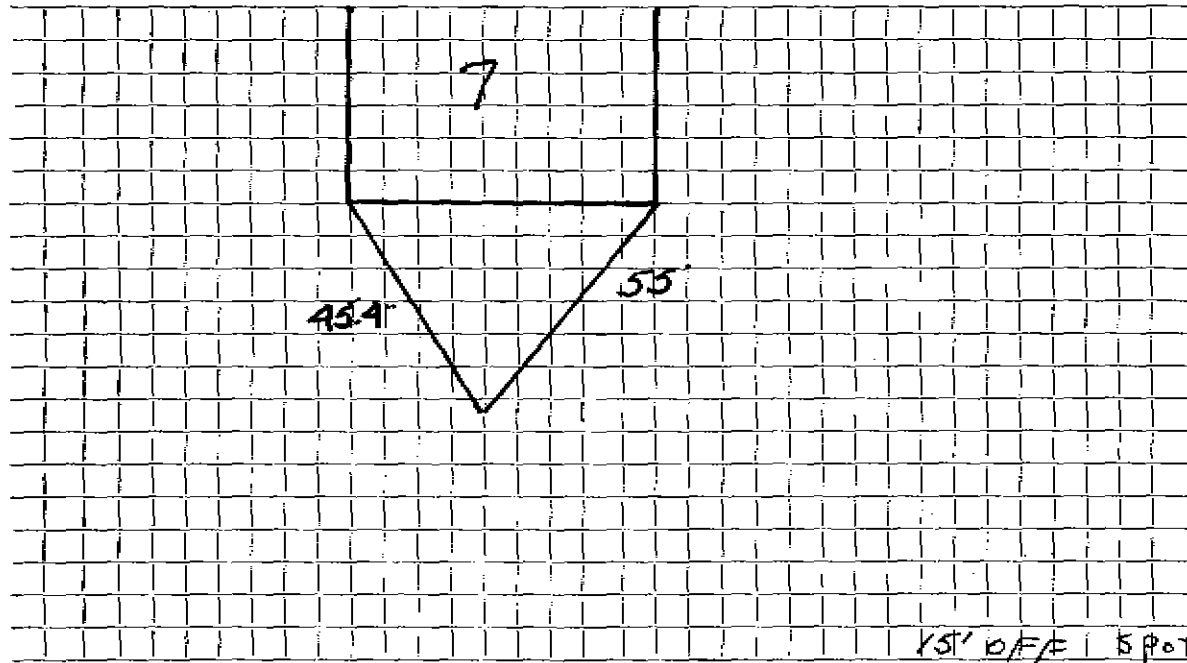

Connection made in Street. Work completed

Remarks:
.....
.....