

WATER SERVICE RECORD

#5112

Name **Herbert E. tabrook**

Service No. **76**

Address **8 Blodgett Road**

Location **Lot #4**

Repair—Renewal—New Service

Comm - 10-14-58


Date	Material	Amount	Total	Date	Amount
5/22/58	Labor	18 67			100 00
	10% Overhead	1 87	20 54	10-14-58	34 46
	72' 3/4" Copper Tubing @37		26 64		65 54
	1 3/4" Cx 1/2 IWH Stop & Waste		5 84	5/18/58	6 21
	1 3/4" C 3 Part Union		2 27	27' - 3/4" Copper Tubing	10 13
	1 Hr Trucking @75		75	1 3/4" C Corp Cock	4 64
	1 Hr Town @6.50		6 50	1 3/4" C Curb Cock	5 94
	1 Hr Allis Chalmers @ 3.00		3 00	1 Box & Rod	4 62
			69 54		31 54
				1 1/2" Straight Tailpiece	50
				1 1/2" Offset Tail Piece	50
					32 54

DATE _____

TOWN OF LEXINGTON — BOARD OF PUBLIC WORKS

WATER DIVISION

Sketch of Service Here

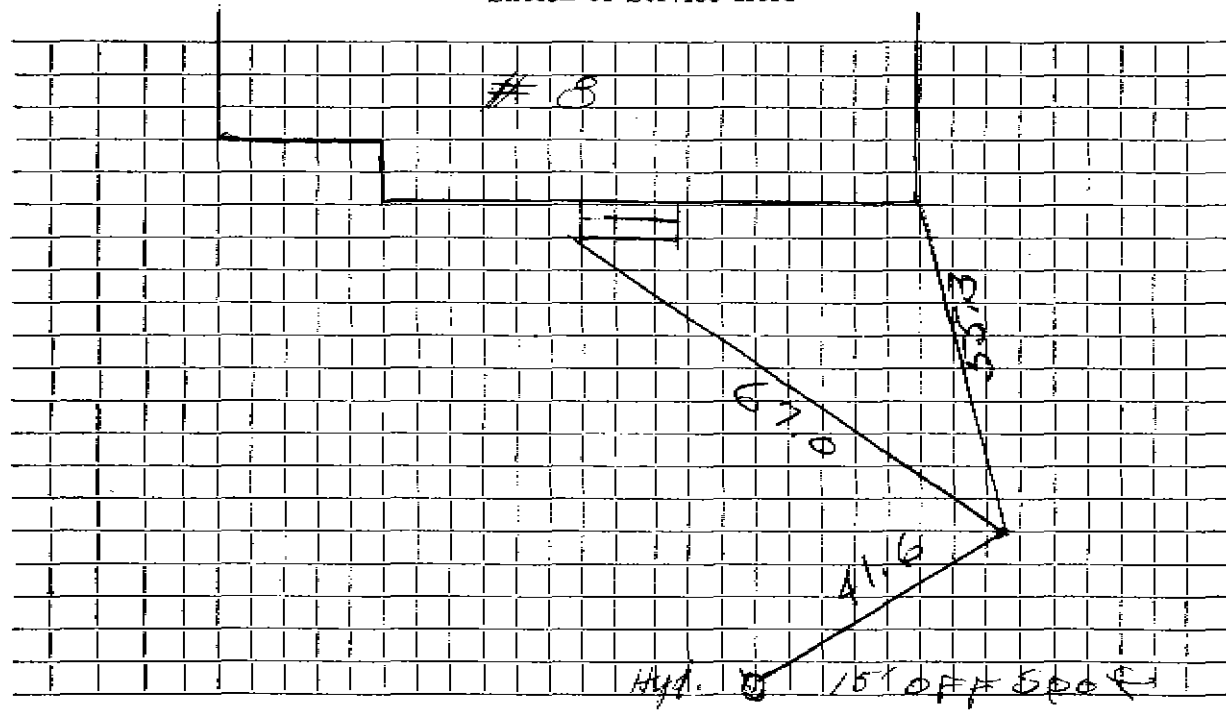

Connection made in Street. Work completed

Remarks:
.....
.....