

Name Fred Dunsford

Service No.

~~304~~ 304

Address

~~84 Oakland Ave. Arlington Heights~~  
11 Bloomfield St.

# 4894

Location // Bloomfield St.

Kind of Pipe

Size

Size of Main

~~Requires Renewal~~—New Service

Location

Date	Material	Amount	Total	Date	Amount
8/10-23-28 for 73.65	57' 1" C.L. Pipe @ .27	15 39			
	2 1" L.L. Ells @ .35	70			
	3 1" L.L. Coup. @ .25	75			
	2 1" Br. Sp. Nip. @ .25	50			
	Trucking	75	18 09		
10/16/	36 Hrs. Labor @ .55	36 30			
	5 " " @ .70	3 50			
10/17/	4 2/3 " " @ .55	2 57			
	4 2/3 " " @ .60	2 80			
	4 2/3 " " @ .70	3 17	48 34		
	15% Overhead		7 25		
	Labor		73 68		
	Time for water & sewer				

Oct. 2, 1928 Cash

73 68

DATE October, 1928

# TOWN OF LEXINGTON—BOARD OF PUBLIC WORKS

## WATER DIVISION

The undersigned applies for a supply of water at No. 11 Bloomfield St. and hereby agrees to comply with the rules and regulations as now, or at any future time, established by the Board of Selectmen.


Am't. of Estimate \$ \_\_\_\_\_

Owner Fred Dunston

Am't. Paid \$ \_\_\_\_\_

Address \_\_\_\_\_

Builder \_\_\_\_\_

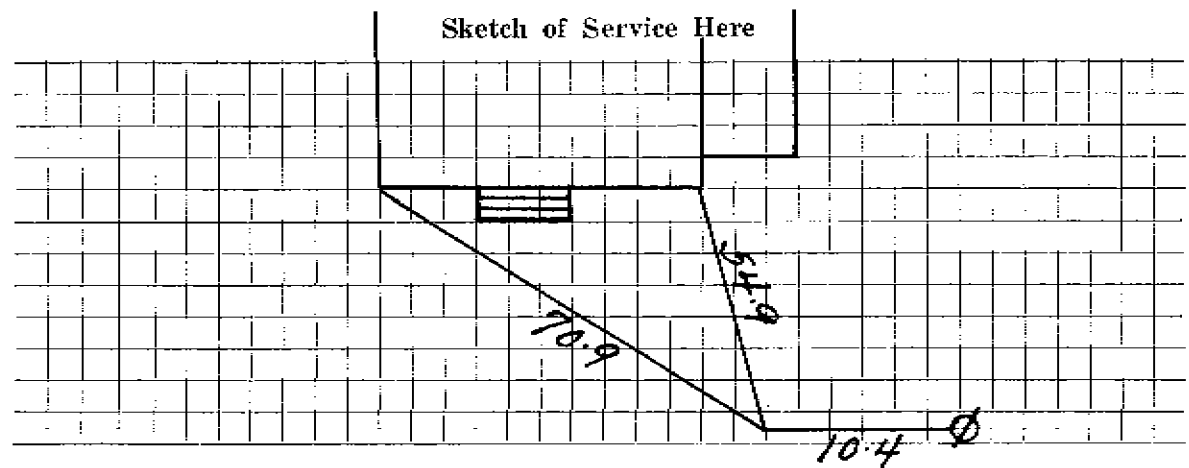

Connection made in \_\_\_\_\_ Street.

Work completed \_\_\_\_\_ 19

Remarks: