

WATER SERVICE RECORD

Name Florence Hamlin

Service No. 41

Address 15 Bloomfield Street

Location

~~Repair~~—Renewal—~~New Service~~ W.O. #1233

APR 8 1974


Date	Material	Amount	Total	Date	Amount
9/5/73	Labor	108.60		9-4-73	500.00
	10% O.H.	10.86	\$119.46	4-19-74	11.30
58'	3/4" Copper @ .60/Ft.		34.80		211.30
1	3/4" Wheel valve		12.01		
1	yd. Loam		5.00		
1	lb. Grass Seed		.95		
	Hot Top Patch		19.98		
2	hrs. Trucking @ 3.00		6.00		
2	hrs. Town Shovel @ 6.50		13.00		
			<u>\$211.20</u>		

DATE _____

TOWN OF LEXINGTON — BOARD OF PUBLIC WORKS

WATER DIVISION

Sketch of Service Here

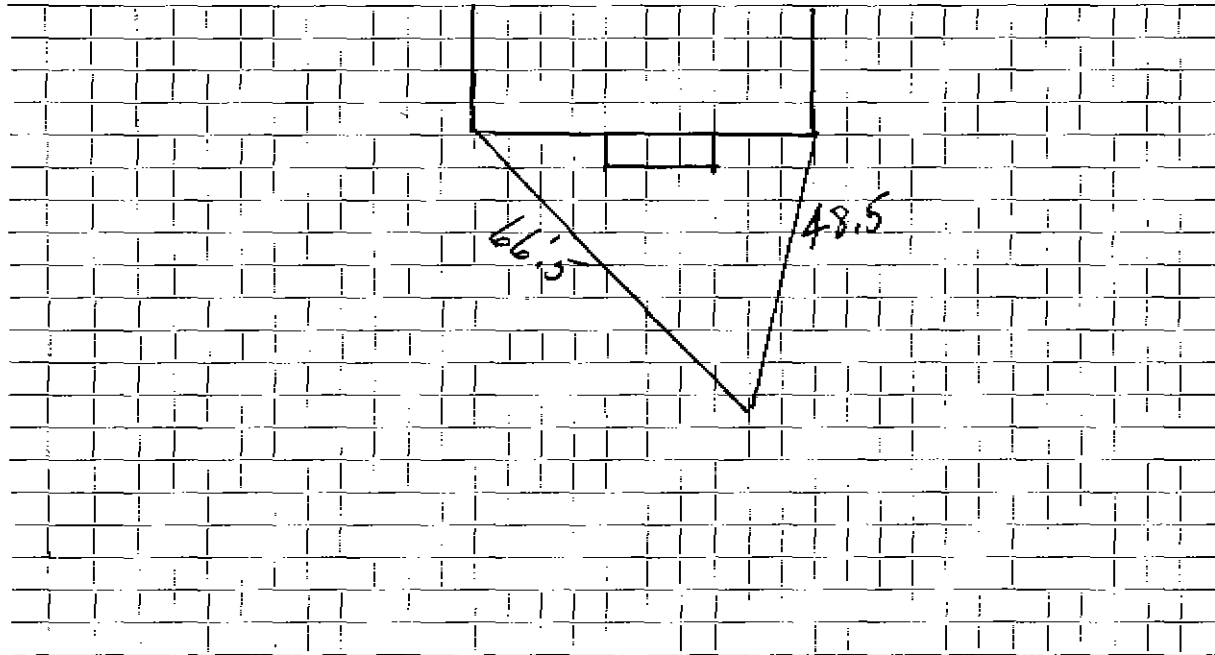

Connection made in Street. Work completed

Remarks:
.....
.....