

Name Susan L. Ball

6355 306
Service No. 1937-#16

Address 16 Bloomfield Street

Location same.

Kind of Pipe

Size

Size of Main

~~Repair~~—Renewal—New Service

Location

Date	Material	Amount	Total	Date	Amount
1937					
4/13/37	41 hrs. @ 55¢	22 55		<i>April 23, 1937 Paid</i>	55 56
<i>Com. 10 50</i>	16 " @ 60¢	9 60	32 15		
	10% Overhead		3 21		
			35 36		
	53' 1" Copper Tubing @ 25¢		13 25		
	1 1" CxC Union		65		
	1 1" Cx1" I. Union		50		
	1 3/4" x 1/2" Bushing		55	<i>2 1/2 50</i>	
	1 1" C x 3/4" I.S. & W.		3 00		
	3 hrs trucking @ 75¢		2 25		
			55 56		
	Labor				

Hadley Press, Inc., Lexington

DATE _____

TOWN OF LEXINGTON—BOARD OF PUBLIC WORKS

WATER DIVISION

The undersigned applies for a supply of water at No. _____ St. and hereby agrees to comply with the rules and regulations as now, or at any future time, established by the Board of Selectmen.

Am't. of Estimate \$ _____

Owner _____


Am't. Paid \$ _____

Address _____

Builder _____

Handwritten signature

Sketch of Service Here

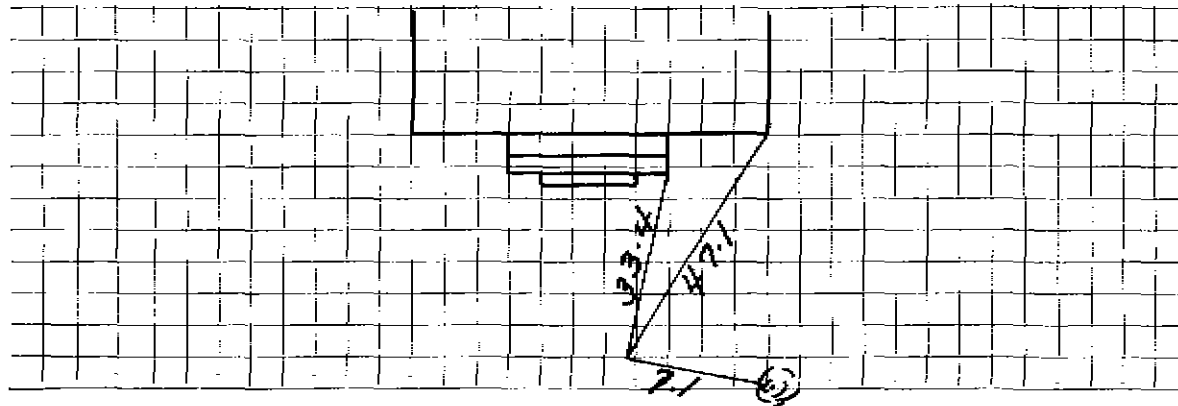

Connection made in _____

Street.

Work completed _____

19

Remarks: