

DATE June 3, 1931

TOWN OF LEXINGTON—BOARD OF PUBLIC WORKS

WATER DIVISION

The undersigned ^{Renewal} applies for a supply of water at No. 23 Bloomfield St. and hereby agrees to comply with the rules and regulations as now, or at any future time, established by the Board of Selectmen.

Am't. of Estimate \$ 15


Owner Mabelle C. Tower

Am't. Paid \$ _____

Address 23 Bloomfield St.
Lexington

Builder _____

Sketch of Service Here

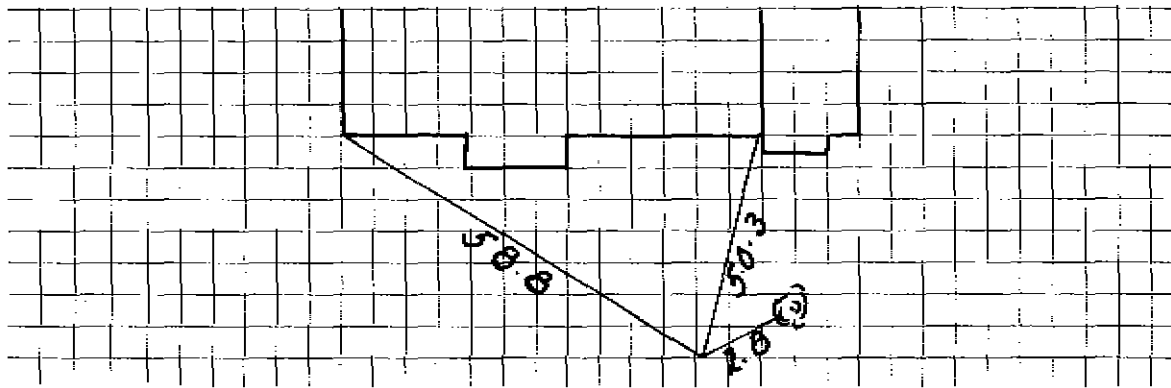

Connection made in _____ Street.

Work completed _____ 19

Remarks: