

Name **Thomas F. Grindle**
 Address **29 Bloomfield St., Town**

Service No. # **309**
 # **6182**

Location

Kind of Pipe

Size

Size of Main

~~Repair~~ ~~Renewal~~ ~~New Service~~ **Water Renewal**

Location

Date	Material	Amount	Total	Date	Amount
45	1" C.L. Pipe @ .27	12 15			
1	1" L.L. Ell	30			
2	1" L.L. Coup @ .25	50			
1	1" Br. Sp. Nipple	25			
1	S & W	3 00			
	Trucking	25	16 45		
5/4/28	33 Hours Labor @ .55	18 15			
4	" " @ .60	2 40	20 55		
	15% Overhead		3 08		
			40 08		

May 26 1928 Cash 40 08
June 24, 1928 Buffalo Box installed
cc

Labor

Hedley Press, Inc. Lexington

DATE _____

TOWN OF LEXINGTON—BOARD OF PUBLIC WORKS

WATER DIVISION

The undersigned applies for a supply of water at No. _____ St. and hereby agrees to comply with the rules and regulations as now, or at any future time, established by the Board of Selectmen.


Am't. of Estimate \$ _____

Owner _____

Am't. Paid \$ _____

Address _____

Builder _____

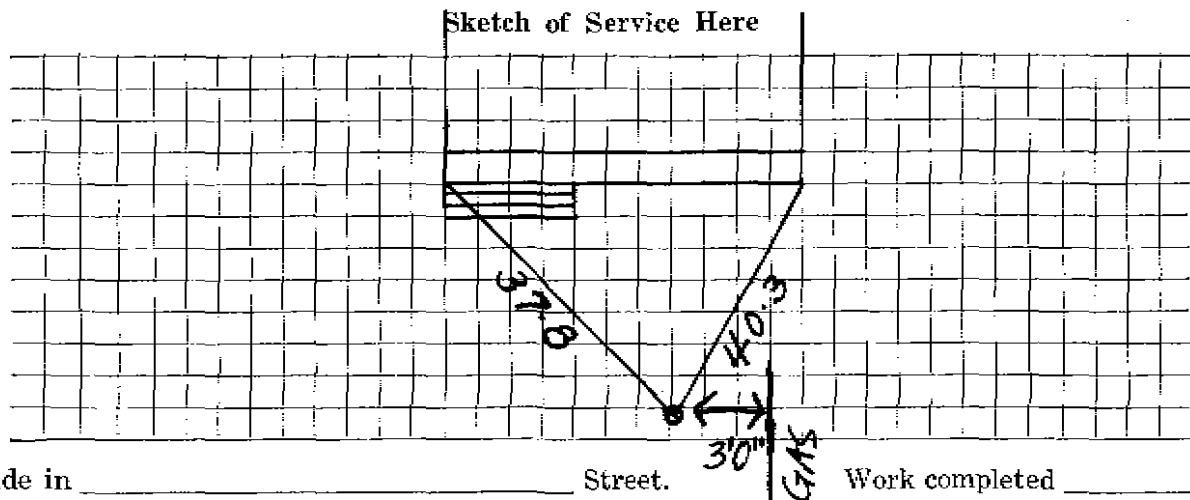

Connection made in _____ Street.

Work completed _____ 19

Remarks: