

Name Home Owners Loan Corp.

Service No. ~~88~~ 314  
#6821

Address ~~150 Beaseway Street, Boston, Mass. (Attention Mr. Carver:)~~  
44 Bloomfield St.

Location 44 Bloomfield Street

Kind of Pipe

Size

Size of Main

~~Repair—Renewal—New Service~~

Location

Date	Material	Amount	Total	Date	Location	Amount
1937						
11/25/37	58 hrs. @ 55¢	31 90		Nov. 24 1937	Paid	93 00
	22 " @ 60¢	13 20				
	19 " @ 70¢	13 30	58 40			
	10% Overhead		5 84			
	71' 3/4" Cop. Tub. @ 25¢		17 75			
	1 3/4" S. & W.		3 75			
	2 3/4" C.Unions- 3 part @ 1.10		2 20			
	1 3/4" CxI Union-2 part		1 00			
	1 3/4"x1/2" Bushing		31			
	5 hrs. trucking @ 75		3 75			
			93 00			
	Labor					

Hadley Press, Inc., Lexington

DATE November 16, 1937

# TOWN OF LEXINGTON—BOARD OF PUBLIC WORKS

## WATER DIVISION

The undersigned applies for a supply of water at No. 44 Bloomfield St., ~~St.~~ and hereby agrees to comply with the rules and regulations as now, or at any future time, established by the Board of Selectmen:

Am't. of Estimate \$ 93.00

Owner

*J. Henry Quinn*  
**J. HENRY QUINN**

ASSISTANT TO STATE MANAGER


IN CHARGE OF PROPERTY MANAGEMENT,  
Home Owners' Loan Corporation

Am't. Paid \$ \_\_\_\_\_

Address

Builder \_\_\_\_\_

Sketch of Service Here

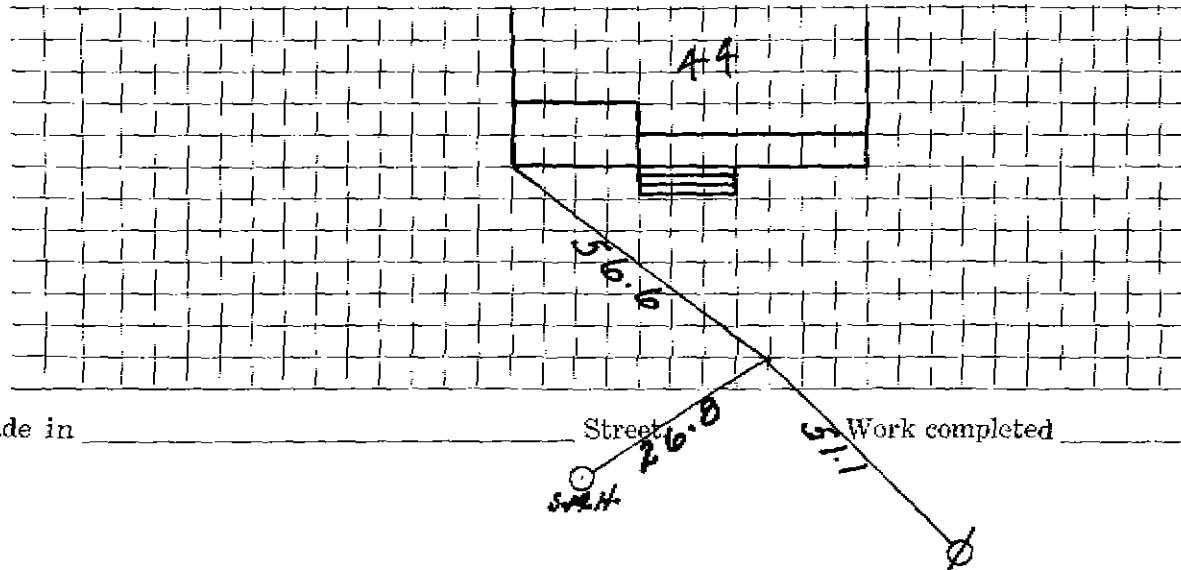

Connection made in \_\_\_\_\_

Street

Work completed \_\_\_\_\_

19

Remarks: