

WATER SERVICE RECORD

#6381

Name George S. Crosby

Service No. 5

Address 47 Bloomfield Street

Location

Repair—Renewal—New Service


Comm. 4-4-60

Date	Material	Amount	Total	Date	Amount
2/25/60	Labor	33 84		2-23-60	Deposit 150 00
	10% overhead	3 38	37 22	4-4-60	Refund 43 98
	65' - 3/4" Copper tubing @ .42		27 30		106 02
	1 3/4" Cx 1/2 I.W.H. Stop & Waste		5 88		
	1 - 3/4" C. Union (3 part)		2 27		
	6 ton Bank Gravel @ .85		5 10		
	4 hrs. Town Shovel @ 6.50		26 00		
	3 hrs. Trucking @ .75		2 25		
			106 02		

TOWN OF LEXINGTON — BOARD OF PUBLIC WORKS

WATER DIVISION

Sketch of Service Here

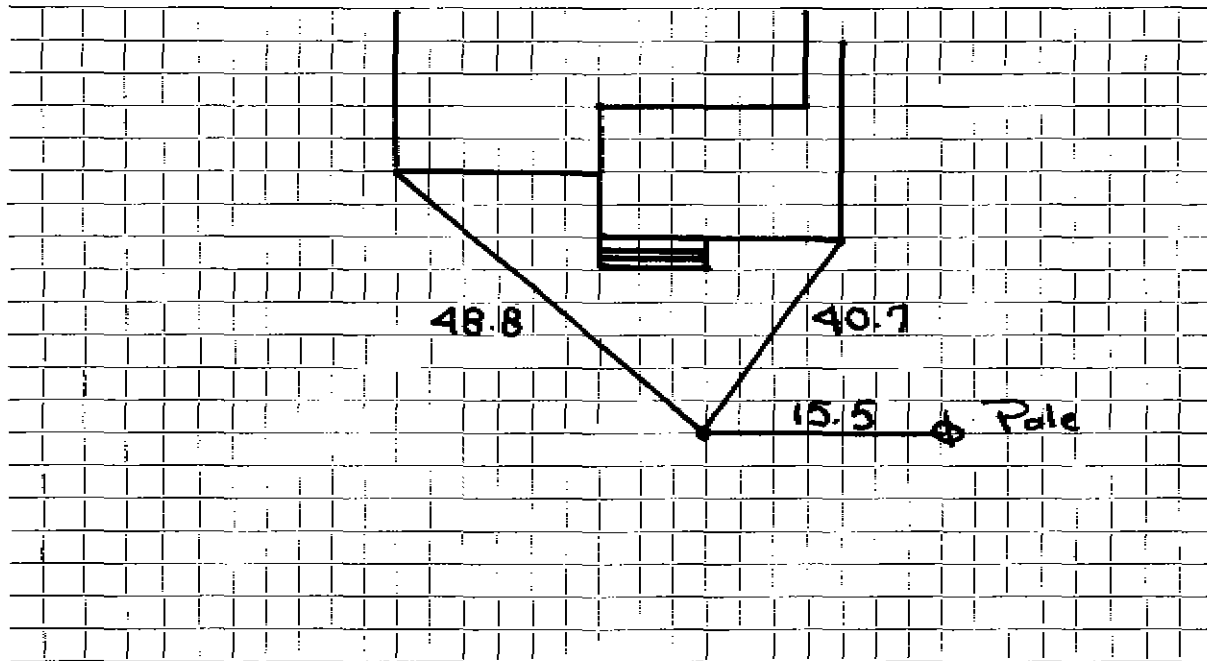

Connection made in Street. Work completed

Remarks:

.....

.....