

Name Woods, George A.

Service No. ~~317~~ 317

Address 51 Bloomfield St., Lexington

Location Same

Kind of Pipe

Size

Size of Main

~~Repair—Renewal—New Service~~

Location

Date	Material	Amount	Total	Date	Amount
7/9/36	42 hrs. labor @ 55¢	23 10		July 13 1936	55 00
14	" " @ 60¢	8 40	31 50	July 21 1936	8 46
10%	Ovhd. on labor @ 18¢		3 15		46 54
48'	3/4" Copper Tub.	8 64			
1	Stop & Waste	1 75			
	Trucking	1 50	11 89		
			46 54		
	Labor				

Hudley Press, Inc., Lexington

DATE July 7 1936

TOWN OF LEXINGTON—BOARD OF PUBLIC WORKS
WATER DIVISION

The undersigned applies for a supply of water at No. 51 Bloomfield St. and hereby agrees to comply with the rules and regulations as now, or at any future time, established by the Board of Selectmen.

Am't. of Estimate \$ 55.00


Owner George A. Woods

Am't. Paid \$ 55.00

Address 51 Bloomfield St
Lexington

Builder _____

Sketch of Service Here

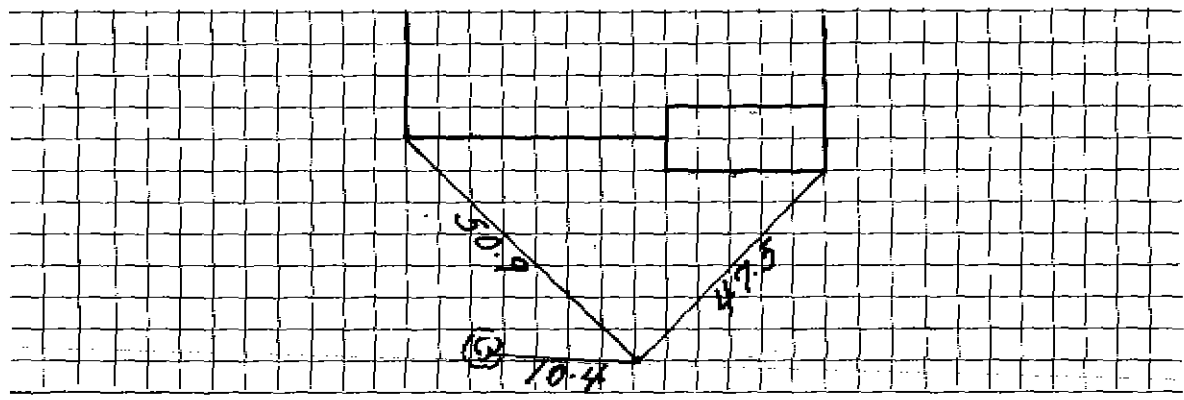

Connection made in _____ Street.

Work completed _____ 19

Remarks: