




DATE 9 MAY 1996

TOWN OF LEXINGTON — BOARD OF PUBLIC WORKS  
WATER DIVISION

Sketch of Service Here

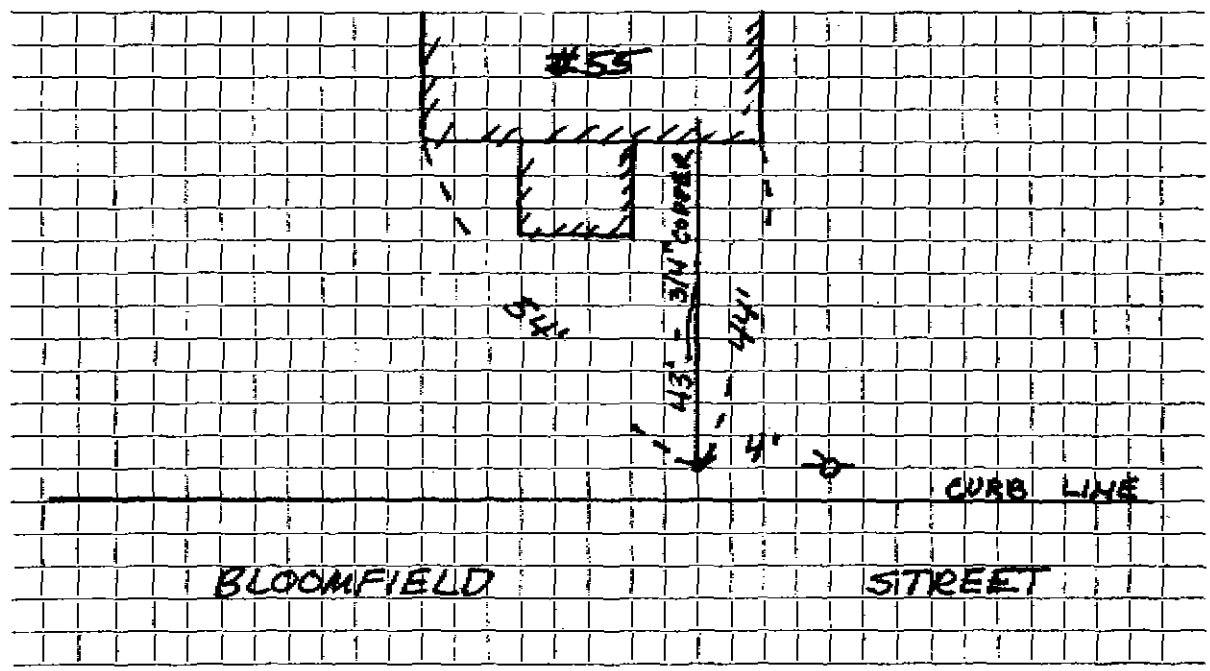

Connection made in BLOOMFIELD STREET Street. Work completed BRUCE MCKEE

Remarks: .....

BOOK 96-3