

WATER SERVICE RECORD

Name M. A. Gilman

Service No. 102

Address 56 Bloomfield Street

Location

~~Blank~~ Renewal ~~W.O.~~ W.O. #8208

Commo-28-63


Date	Material	Amount	Total	Date		Amount
9-7-63	Labor	57.36		9-23-63	Deposit	150.00
	10% O.H.	5.74	63.10	10-28-63	Refund	5.06
53'	3/4" Copper tubing @.42		22.26			148.94
1	3/4" CX 1/2 I.W.H. Stop & Waste		6.17			
1	3/4" C3 Part Union		2.41			
					NON CHARGE	
5	Yards Loam @3.00		15.00	9-2-63	1 1/2 Straight tailpiece	50
4'	Patching		4.00		1 1/2 Offset tailpiece	50
4	Hrs. Town Shovel @6.50		26.00			1.00
2	Hrs. Trucking @3.00		6.00			
			144.94			

TOWN OF LEXINGTON — BOARD OF PUBLIC WORKS

WATER DIVISION

DATE

Sketch of Service Here

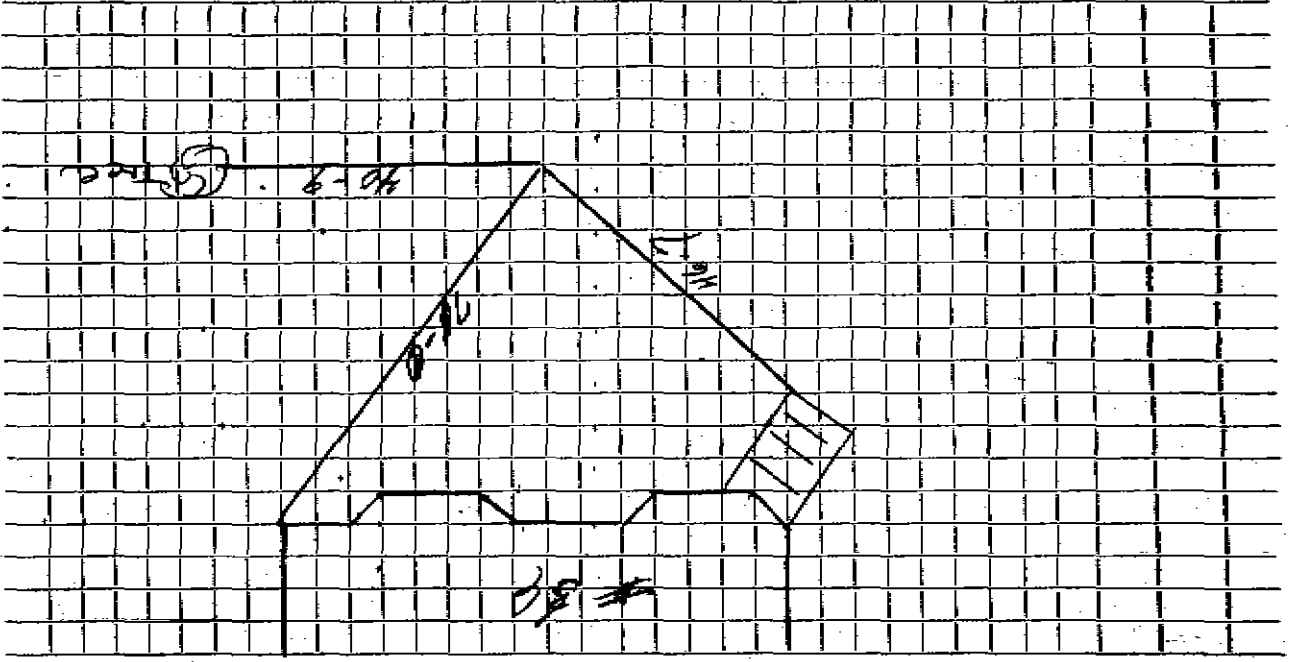

Connection made in Street. Work completed

Remarks: