

Name L. J. Reynolds

320 65  
Service No.

Address ~~1736 Mass. Ave., Lexington,~~  
60 Bloomfield St.

# 5921

Location 60 Bloomfield St.,

Kind of Pipe

Size

Size of Main

Repair—Renewal—New Service

Location

Date	Material	Amount	Total	Date	Amount
1/13/41	28½ hrs. @ 55¢	15 68		December 11, 1940 Deposited	75 00
Com 2-10-41	52 " @ 60¢	31 20			
	9½ " @ 70¢	<u>6 65</u>	53 53		
	10% Overhead		5 35		
	64' 3/4" Copper tubing @ 19¢		12 16		
	1 3/4" C. Union (3 parts)		90		
	1 1" 3/4" Bushing		30		
	1 3/4" C. Stop & Waste		2 25		
	Compressor, 3 hrs. @ 3.00		9 00		
	Trucking, 2 hrs. @ 75¢		<u>1 50</u>		
			\$84 99		
	<i>George J. ...</i> Labor				

Hadley Press, Inc., Lexington

DATE Dec 9, 1940

# TOWN OF LEXINGTON - BOARD OF PUBLIC WORKS

## WATER DIVISION

The undersigned applies for a supply of water at No. 60 Bloomfield St. and hereby agrees to comply with the rules and regulations as now, or at any future time, established by the Board of Selectmen.


Am't. of Estimate \$ 75.00

Am't. Paid \$ \_\_\_\_\_

Builder \_\_\_\_\_

Deposit made by  
Owner L. J. Reynolds  
Address Lexington  
Mass.

Sketch of Service Here

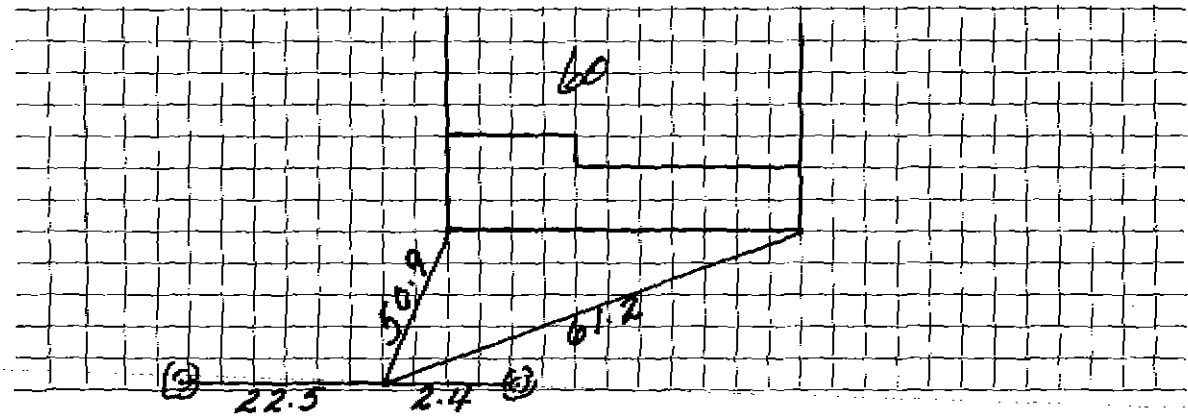

Connection made in \_\_\_\_\_ Street.

Work completed \_\_\_\_\_ 19

Remarks: