

Name O'Connor & Quinn

Service No. ~~20~~ 321

Address ~~4374 Mass. Ave., Cambridge~~

63 Bloomfield St.

63 Bloomfield St.

Location ~~Cor. Highland &~~ Bloomfield St.

Kind of Pipe

Size

Size of Main

~~Repair - Renewal~~ - New Service

Location

Date	Material	Amount	Total	Date	Amount
P. 3-26-29 for 98.75	60' 1" C.L. Pipe @.27	16 20			
	4 1" L.L. Coup. @.30	1 20		March 15 1929 - Cash	98 75
	2 1" L.L. Ells @.35	70			
	1 1" C.L. Nipple	25			
	1 1" S & W	3 00		4-20-04	Outside RENEWED
	Trucking	75	22 10		1" - Copper
3/25/29	83 Hrs. Labor @.55	45 65			
	35 " " @.60	21 00	66 65	4-16-04	Inside RENEWED
	15% Overhead		10 00		1" Copper
			98 75		
	Labor is for both water and sewer				

Lindley Press, Inc., Lexington

DATE March 4, 1929

TOWN OF LEXINGTON—BOARD OF PUBLIC WORKS

WATER DIVISION

The undersigned applies for a supply of water at No. <sup>63</sup> Bloomfield <sup>cont. Highland Ave.</sup> St. and hereby agrees to comply with the rules and regulations as now, or at any future time, established by the Board of Selectmen.


Am't. of Estimate \$ \_\_\_\_\_

Owner O'Connor Ed Linnin

Am't. Paid \$ \_\_\_\_\_

Address 137 1/2 Mass Ave, Camb.

Builder O'Connor & Linnin By J.H. Linnin

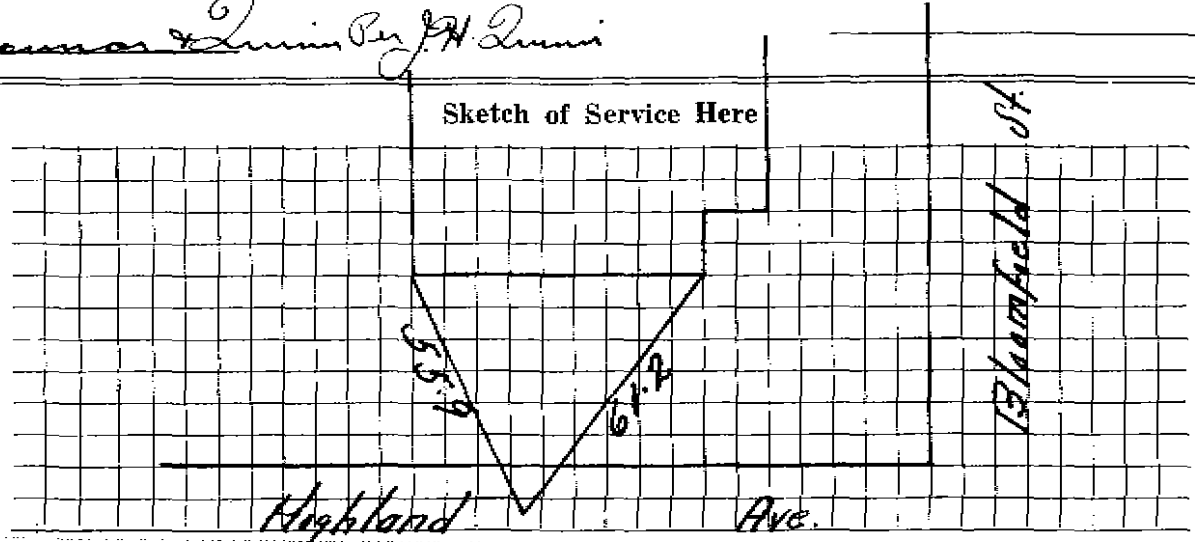

Connection made in \_\_\_\_\_ Street.

Work completed \_\_\_\_\_ 19

Remarks: