

WATER SERVICE RECORD

Name Timothy P. Hart

Service No. 11

Address 64 Bloomfield St. Lexington, Mass.

Location

~~Repair~~ ~~Renewal~~ New Service WO #4193


Date	Material	Amount	Total	Date	Amount
4/5/76	labor	65. 84		4/2/76	Deposit 350. 00
4/7/76	labor	43. 44		11/2/76	7. 52
	10%OH	10. 92	120. 20		315. 155
65'	1" copper tubing @	1.30	84. 50		OUTSIDE
1	1" wheel stop		15. 16	4/5/76	labor 65. 84
1	1" X 3/4" bushing		1. 72	4/7/76	labor 65. 16
1	1" 3 part union		7. 77	27'	1" copper @ 1.30 35. 10
2 1/2	hrs. shovel @ 6.50		16. 25	1	1" corp 16. 69
2	hrs. truck @ 3.00		6. 00	1	1" curb cock 18. 67
5	yds. loam @ 4.50		22. 50	1	box and rod 15. 40
2	lbs. seed @ .35		7. 00	2	tons cold patch @ 13. 70 27. 40
	Trench 26 X 6		103. 98	4	yds. loam @ 4.50 18. 00
			385. 08	10	lbs. seed @ .35 3. 50
				2	hr. trucking @ 3.00 6. 90
				3	hr. shovel @ 6.50 19. 50
					291. 26

DATE _____

TOWN OF LEXINGTON — BOARD OF PUBLIC WORKS

WATER DIVISION

Sketch of Service Here

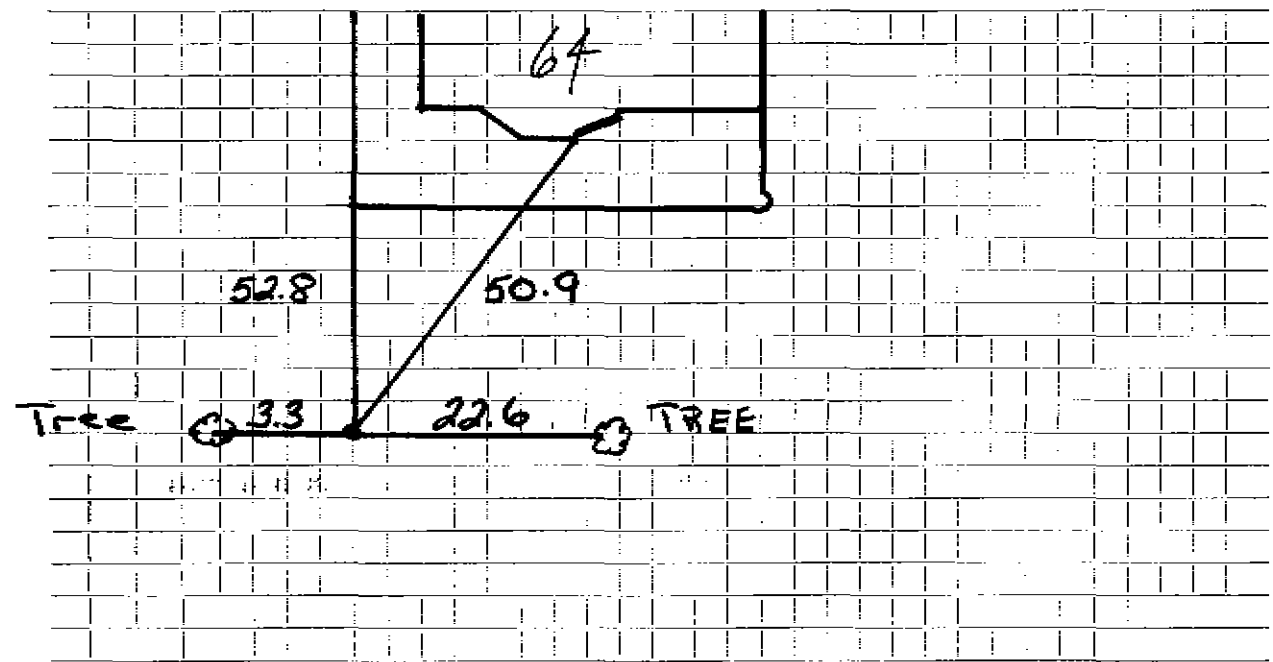

Connection made in Street. Work completed

Remarks:
.....
.....