

WATER SERVICE RECORD

Name Bernard Danti

Service No.

422
4#6781

Address 73 Bloomfield Street

Location

~~Repair~~ Renewal ~~New Service~~ W.O. # 7410

JUL 27 1970


Date	Material	Amount	Total	Date	Amount
3/23/70	Labor	35 02		3-17-70	Deposit 200 00
	10% O.H.	3 50	38 52	7-27-70	Refund 111 64
33'	3/4" Copper pipe .79		26 07		88 39
1	3/4" Wheel Valve		9 30		
1	Hr. trucking		3 00		
1	Hr. shovel		6 50		
					<u>OUTSIDE</u>
1	Hr. compressor		5 00	3/23/70	Labor 70 04
			88 39	5/8/70	" 22 74
				32'	3/4" Copper pipe .79 25 28
				1	3/4" Curb cock 11 32
				1	3/4" Adaptor 2 76
				2	Hrs. trucking 3.00 6 00
				3	" shovel 4.00 12 00
					150 14

DATE _____

TOWN OF LEXINGTON -- BOARD OF PUBLIC WORKS

WATER DIVISION

Sketch of Service Here

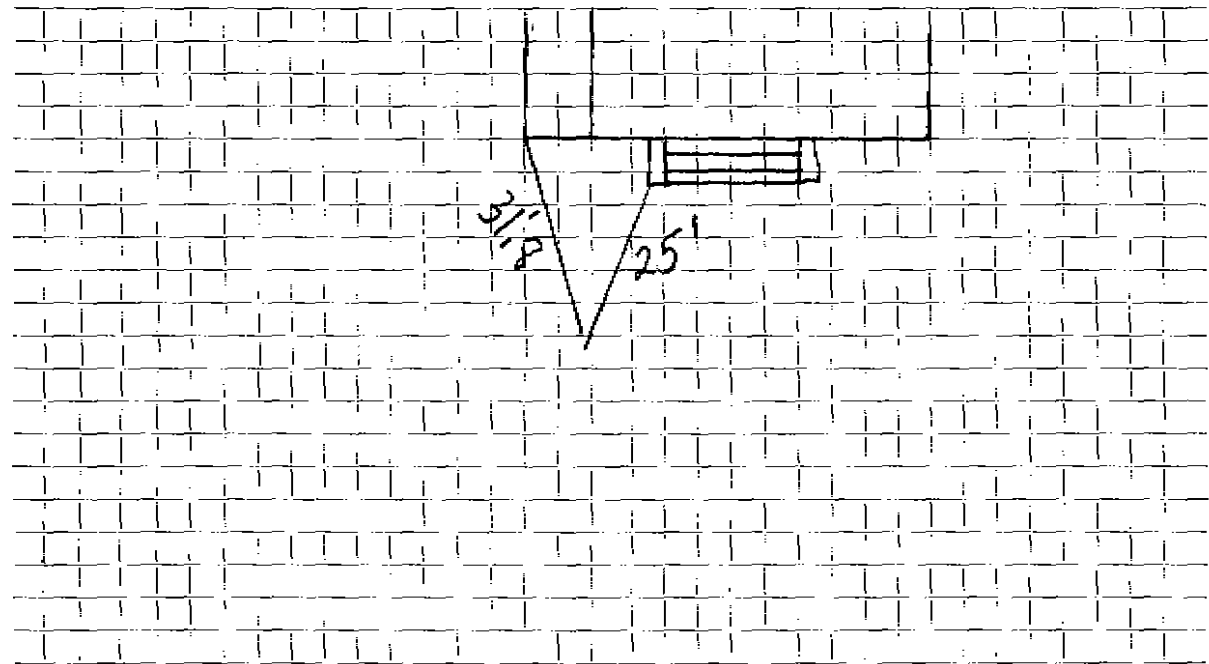

Connection made in Street. Work completed

Remarks:
.....
.....

WATER SERVICE RECORD

#4687

Name Arthur Graves

Service No. 150

Address 76 Bloomfield Street

Location Lexington

~~Renewal - New Service~~

Com. 9-22-52


Date	Material	Amount	Total	Date	Amount
8/19/52	Labor	23 55		7-23-52 Deposited	30 00
	10% Overhead	2 36	25 91	9-22-52 Refunded	(5 96)
	45' - 3/4" copper tubing @ .3439	15 48			NON CHARGE
	1 - 3/4" C x 1/2 I.W.H. stop & waste	4 00		8/19/52 Labor	30 00
	1 hr. trucking		75	15' - 3/4" Copper tubing @ .3439	5 16
			46 14	1 - 3/4" C. Corp-cock @ 4.33	4 33
				1 - 3/4" C x 3/4" C. Curb-cock @ 1.67	4 67
				1 Box & Rod @ 3.90	3 90
				1 - 1/2 offset tail piece @ .50	50
				1 - 1/2 straight tail piece @ .50	50
				2 hrs. Littlefield shovel	14 00
				1 hr. trucking	75
					63 81

DATE _____

TOWN OF LEXINGTON — BOARD OF PUBLIC WORKS

WATER DIVISION

Sketch of Service Here

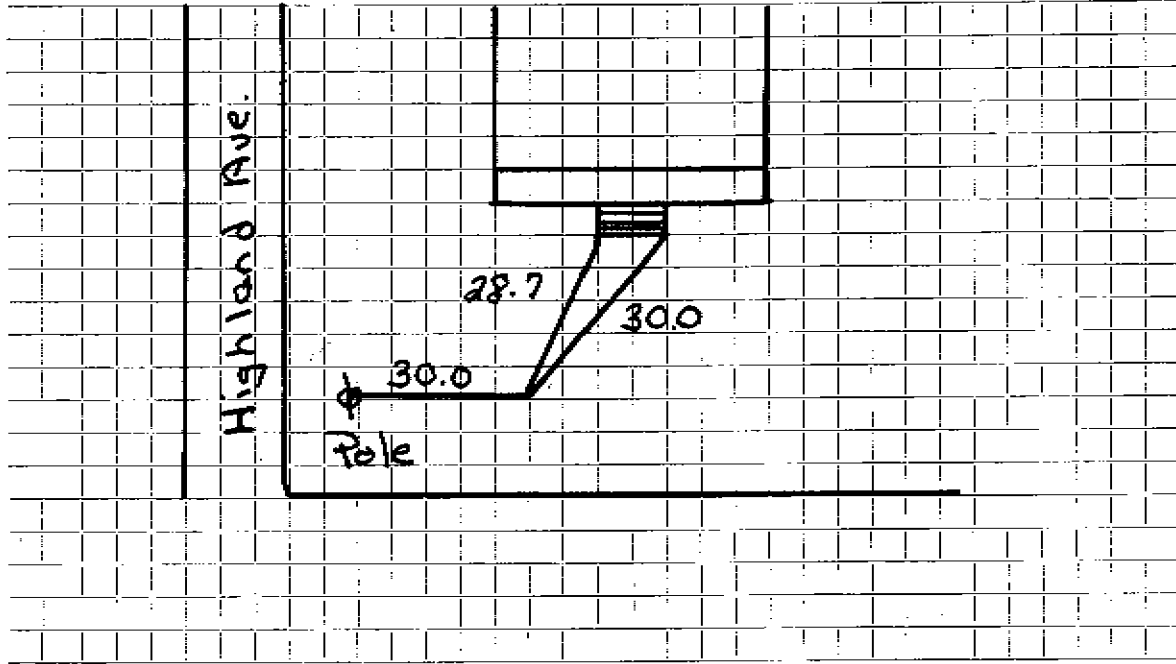

Connection made in Street. Work completed

Remarks:

.....

.....