

## WATER SERVICE RECORD

Name C. H. Lothrop

Service No. 99

Address 83 Bloomfield Street

Location

~~Repair~~ - ~~Renewal~~ - ~~New Service~~*Conn. 6-1-54*


Date	Material	Amount	Total	Date	Amount
4/30/54	Labor	22 80		4-29-54 Deposited	50 00
	10% Overhead	2 28	25 08	6-1-54 Refunded	( 1 66
	40' 1" Copper tubing @.4502	18 01		<u>NON CHARGE</u>	48 34
	1 1" Cx1" I.W.H. stop & waste	4 50	4/30/54	Labor	48 00
	1 Hr. trucking	75	48 34	1 - 1" Cx1" C. curb-cock	6 80
				1 Box & Rod	3 90
				1 - 1" straight tail piece	93
				1 - 1" offset tail piece	93
					<u>60 56</u>

DATE \_\_\_\_\_

TOWN OF LEXINGTON — BOARD OF PUBLIC WORKS

**WATER DIVISION**

Sketch of Service Here

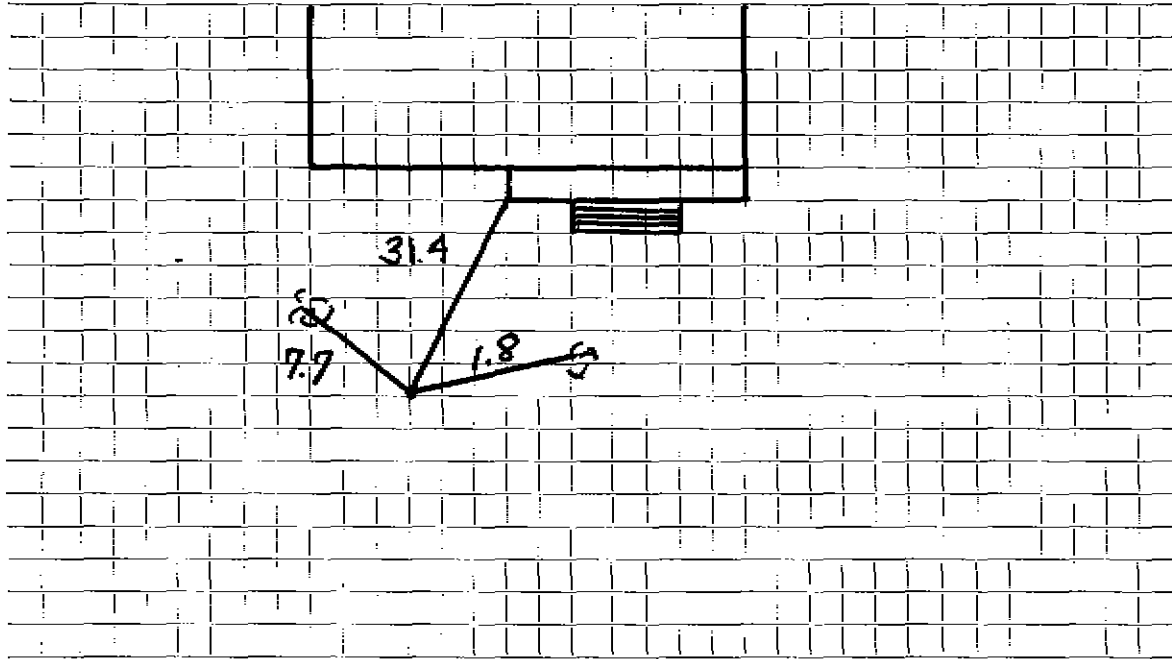

Connection made in ..... Street.      Work completed .....

Remarks: .....

.....

.....