

WATER SERVICE RECORD

Name S & A Realty Trust

Service No.

Address 86 Bloomfield Street

Location

Repair—Renewal—New Service Lucente #515


Date	Material	Amount	Total	Date	Amount
1/6/67 49'	3/4" Copper tubing			6/25/65	
				14' 3/4 COPPER	
				1 3/4 COP	
				1 3/4 CURB STOP	
				1 Box + Rod	

DATE _____

TOWN OF LEXINGTON — BOARD OF PUBLIC WORKS

WATER DIVISION

Sketch of Service Here

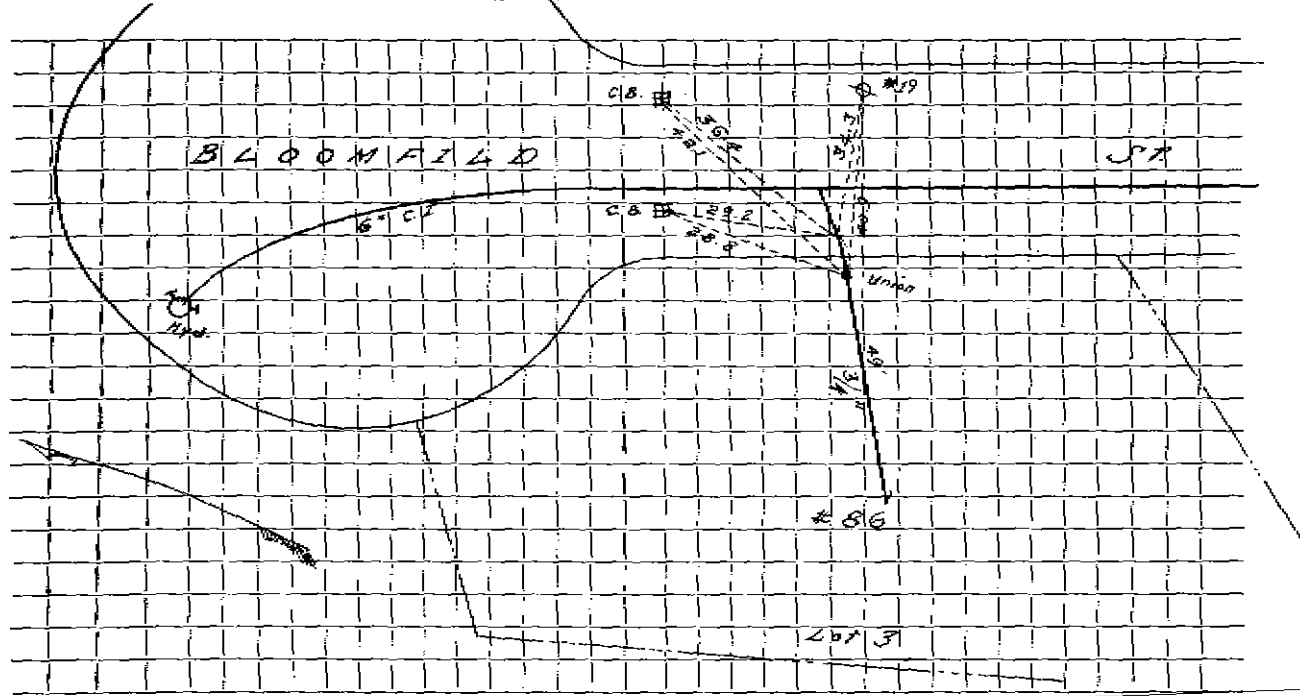

Connection made in Street. Work completed

Remarks:
.....
.....