

WATER SERVICE RECORD

Name *Renaissance Const.*

Service No.

Address *10 Blossom Street*

Location

~~Repair—Renewal—New Service~~ *Redmond #4117*

~~XXXXXX~~


| Date | Material | Amount | Total | Date | Material | Amount |
|---------------|--------------------------------|--------|-------|---------------|-------------------------------|--------|
| <i>4/2/85</i> | <i>70' x 1" Copper Tubbing</i> | | | | | |
| | <i>1 1" x 3 Part Union</i> | | | | | |
| | <i>1 1" R.H. Wheel Valve</i> | | | | | |
| | | | | | <i>OUTSIDE</i> | |
| | | | | <i>4/2/85</i> | <i>23' x 1" Copper tubing</i> | |
| | | | | | <i>1 1" Corp Cock</i> | |
| | | | | | <i>1 1" Curb Cock</i> | |
| | | | | | <i>Box & Rod</i> | |

DATE March 6, 1985

TOWN OF LEXINGTON — BOARD OF PUBLIC WORKS

WATER DIVISION

Sketch of Service Here

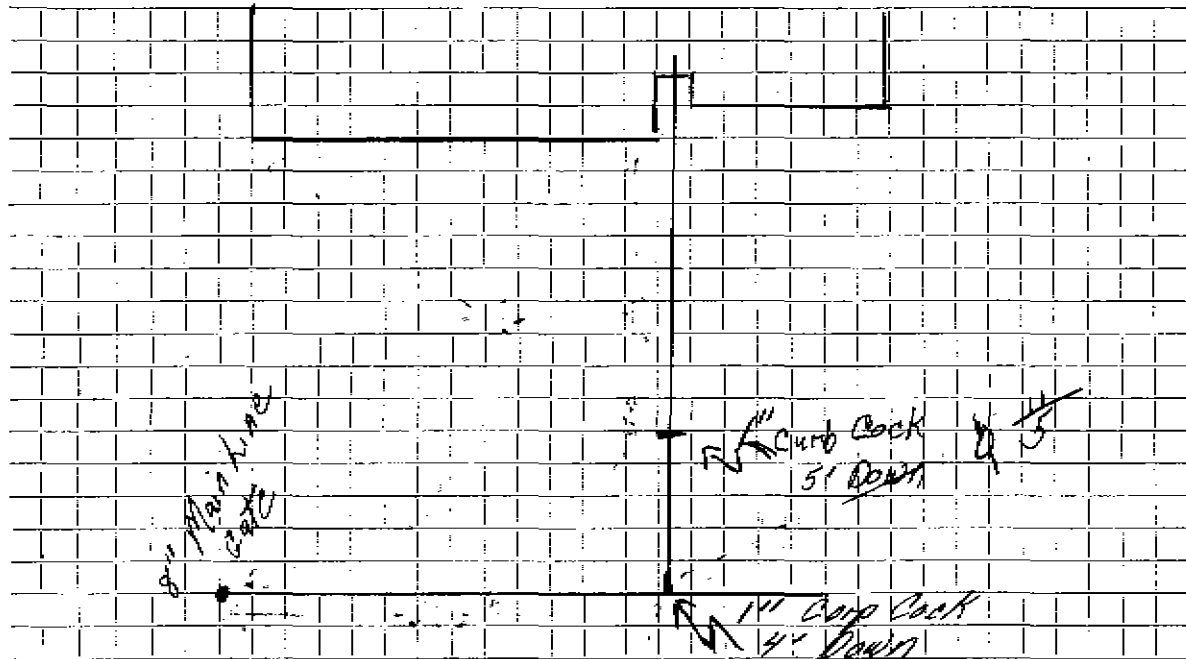

Connection made in Blossom St. Street.

Work completed April 2, 1985

Remarks:

.....

.....