

#6178

Name Mr. Edwin W. Hutchinson

Service No. 53 3152

Address ~~169 Blossom Street~~ 12 Blossom Street (Eng. 11-2-66) <sup>12</sup>

72.90

Lexington, Mass.

Location ~~169 Blossom Street~~

Kind of Pipe

Size

Size of Main

~~Repair—Renewal—New Service~~

Com. 9-23-46

Location

Date	Material	Amount	Total	Date	Location	Amount
July 10, '46	Labor	48 23	48 23	July 10, '46	Deposited	100 00
	10% Overhead		4 82	Oct 10 '46	Refunded	7 44
	90' - 3/4" Copper Tubing @.1911		17 20		Non-Charge	92 86
	1-3/4" C x 3/8" I.W.E. Stop & Waste		2 82	July 10, '46	Labor	25 19
	1 - 3/4" C Union (3 parts)		1 04	July 11, '46	"	7 84
	Patching 18' x 3"		18 00		28' - 3/4" Copper Tubing @.1911	4 20
	Trucking 1 hr. @.75		75		1 - 3/4" C Corp-cock	2 70
			92 86		1 - 3/4" C x 3/8" C Curb-cock	3 30
					1 - Box & Rod	1 65
					2 - 1/2" Straight Tail Pieces	1 30
					Compressor 2 hrs. @.75	3 50
					Trucking 1 hr. @.75	75
	Labor					51 03

Hadley Press, Inc., Lexington

DATE \_\_\_\_\_

# TOWN OF LEXINGTON—BOARD OF PUBLIC WORKS

## WATER DIVISION

The undersigned applies for a supply of water at No. \_\_\_\_\_ St. and hereby agrees to comply with the rules and regulations as now, or at any future time, established by the Board of Selectmen.


Am't. of Estimate \$ \_\_\_\_\_

Owner \_\_\_\_\_

Am't. Paid \$ \_\_\_\_\_

Address \_\_\_\_\_

Builder \_\_\_\_\_

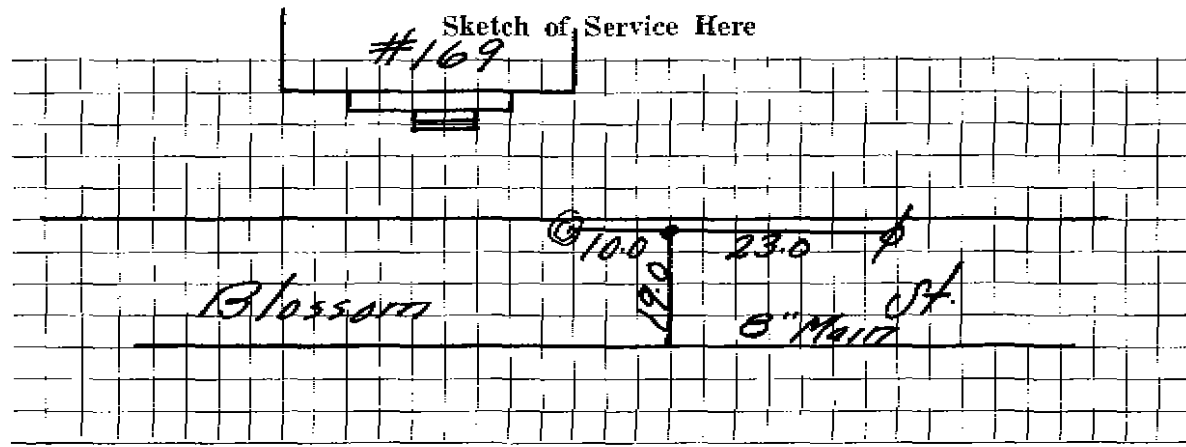

Connection made in \_\_\_\_\_ Street.

Work completed \_\_\_\_\_ 19

Remarks: