

# 4453 # 4467

Name Selby Ollerhead

Service No.

Address ~~XXXXXXXXXXXXXXXXXXXXXXXX~~ 14 Blossom Street (Per Eng. 11-2-66) *Blossom St*  
 Lexington, Mass. Location ~~XXXXXXXXXXXXXXXXXXXXXXXX~~

Kind of Pipe ~~XXXXXXXXXXXXXXXXXXXXXXXX~~ Size ~~XXXXXXXXXXXXXXXXXXXXXXXX~~ Size of Main ~~XXXXXXXXXXXXXXXXXXXXXXXX~~  
~~XXXXXXXXXXXXXXXXXXXXXXXX~~ Location ~~XXXXXXXXXXXXXXXXXXXXXXXX~~

~~XXXXXXXXXXXXXXXXXXXXXXXX~~ ~~XXXXXXXXXXXXXXXXXXXXXXXX~~ - New Service Com. 2-21-49

Date	Material	Amount	Total	Date	Location	Amount
Jan. 20, '49	Labor	3 60	3 60	Jan. 19, '49	<i>Deposited</i> <i>Expended</i> Non-Charge	75 00
	10% Overhead		36	<i>Feb 21, 1949</i>		<i>11 00</i>
	50' - 3/4" Copper Tubing @.27	13 50				<i>58 18</i>
	1 - 3/4" C x 3/8" I.W.F. S&W		3 15	Jan. 20, '49	Labor	3 60
	1 - 3/4" C x 3/4" C Union (3 pt)		1 32	27' - 3/4" Copper Tubing @.27		7 29
	Littlefield Shovel 2 1/2 hrs @7.00		17 50	1 - 3/4" C Corp-cock		3 00
	Trucking 1 hr.		75	1 - 3/4" C x 3/4" C Curb-cock		3 68
	Patching 18 x 3		18 00	1 - Box & Rod		3 55
			58 18	1 - 1/2" Offset tail piece		30
				1 - 1/2" Straight Tail Piece		30
				Littlefield Shovel 2 hrs. @7.00		14 00
				Trucking 1 hr.		75
	Labor					36 47

DATE \_\_\_\_\_

TOWN OF LEXINGTON - BOARD OF PUBLIC WORKS

**WATER DIVISION**

The undersigned applies for a supply of water at No..... St. and hereby agrees to comply with the rules and regulations as now, or at any future time, established by the Board of Selectmen.

Am't of Estimate \$.....

Owner .....


Am't Paid \$.....

Address .....

Builder .....

.....

Sketch of Service Here

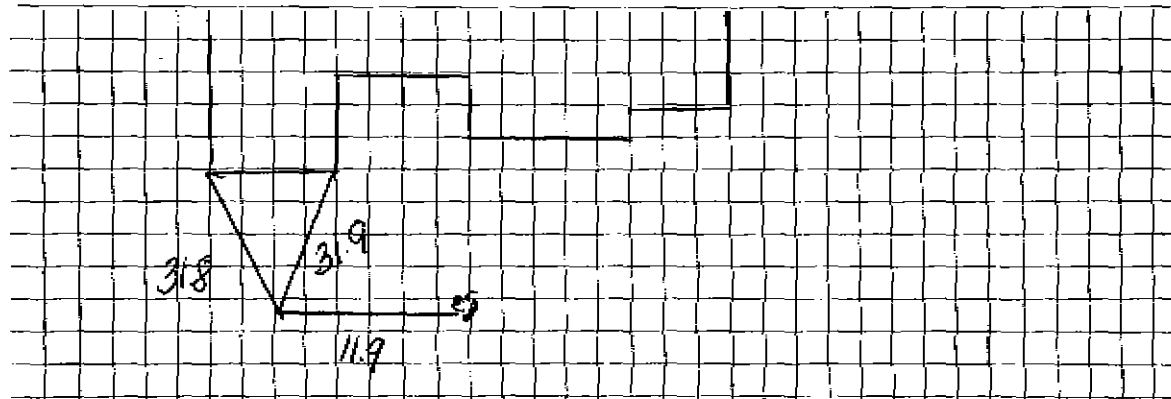

Connection made in ..... Street.

Work completed .....19

Remarks: