

Name George E. Krah, Jr.

Service No. #1962

Address ~~18 Blossom Street~~ 18 Blossom Street (Per Eng. 11-2-66)

Lexington, Mass.

Location ~~18 Blossom Street~~

Kind of Pipe

Size

Size of Main

~~Repair~~ ~~Renewal~~ - New Service

Location

Date	Material	Amount	Total	Date	Amount
Dec. 18, '48	Labor	5 70	5 70	Dec. 11, '48	25 00
	10% Overhead		57		4 00
	63' - 3/4" Copper Tubing @ .255	16 07			70 06
	1 - 3/4" C x 3/8" I.W.H. S & W	3 15		Dec. 18, '48	5 70
	1 - 3/4" C x 3/4" Union (pts)	1 32		30' - 3/4" Copper Tubing @ .255	7 65
	Shovel 3 1/2 hrs. @ 7.00	24 50		1 - 3/4" C Core-cock	3 00
	Trucking 1 hr. @ .75	75		1 - 3/4" C x 3/4" Carb-cock	3 68
	Patching 18 x 3		18 00	1 - 1/2" Offset Tail Piece	30
			70 06	1 - 1/2" Straight Tail Piece	30
				1 - Box & Rod	3 55
				Littlefield Shovel 3 hrs. @ 7.00	21 00
				Trucking 1 hr. @ .75	75
	Labor				45 93

Deposited
Refunded
Non-Charge

DATE _____

TOWN OF LEXINGTON - BOARD OF PUBLIC WORKS

WATER DIVISION

The undersigned applies for a supply of water at No. St. and hereby agrees to comply with the rules and regulations as now, or at any future time, established by the Board of Selectmen.

Am't of Estimate \$.....

Owner


Am't Paid \$.....

Address

Builder

.....

Sketch of Service Here

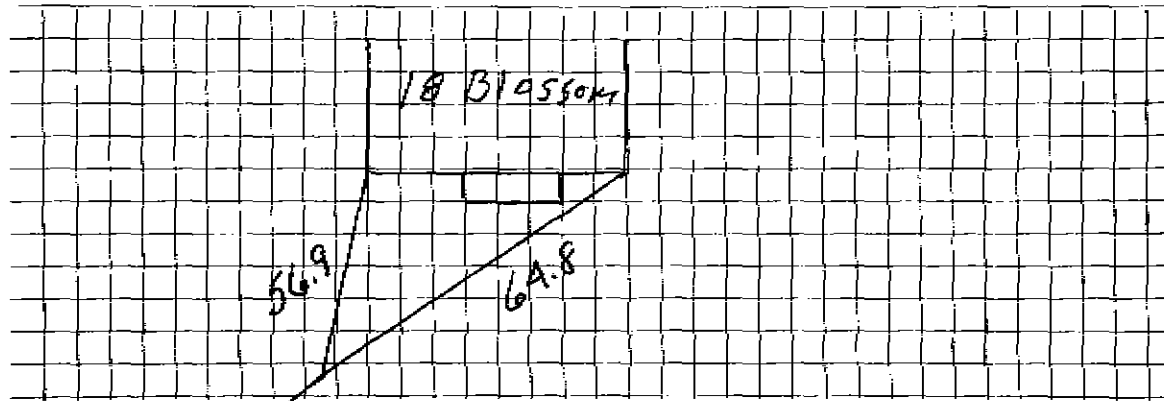

Connection made in Street.

Work completed19

Remarks:

41.6