


Water Service Tie Card
TOWN OF LEXINGTON

2 Blossom St

MASSACHUSETTS

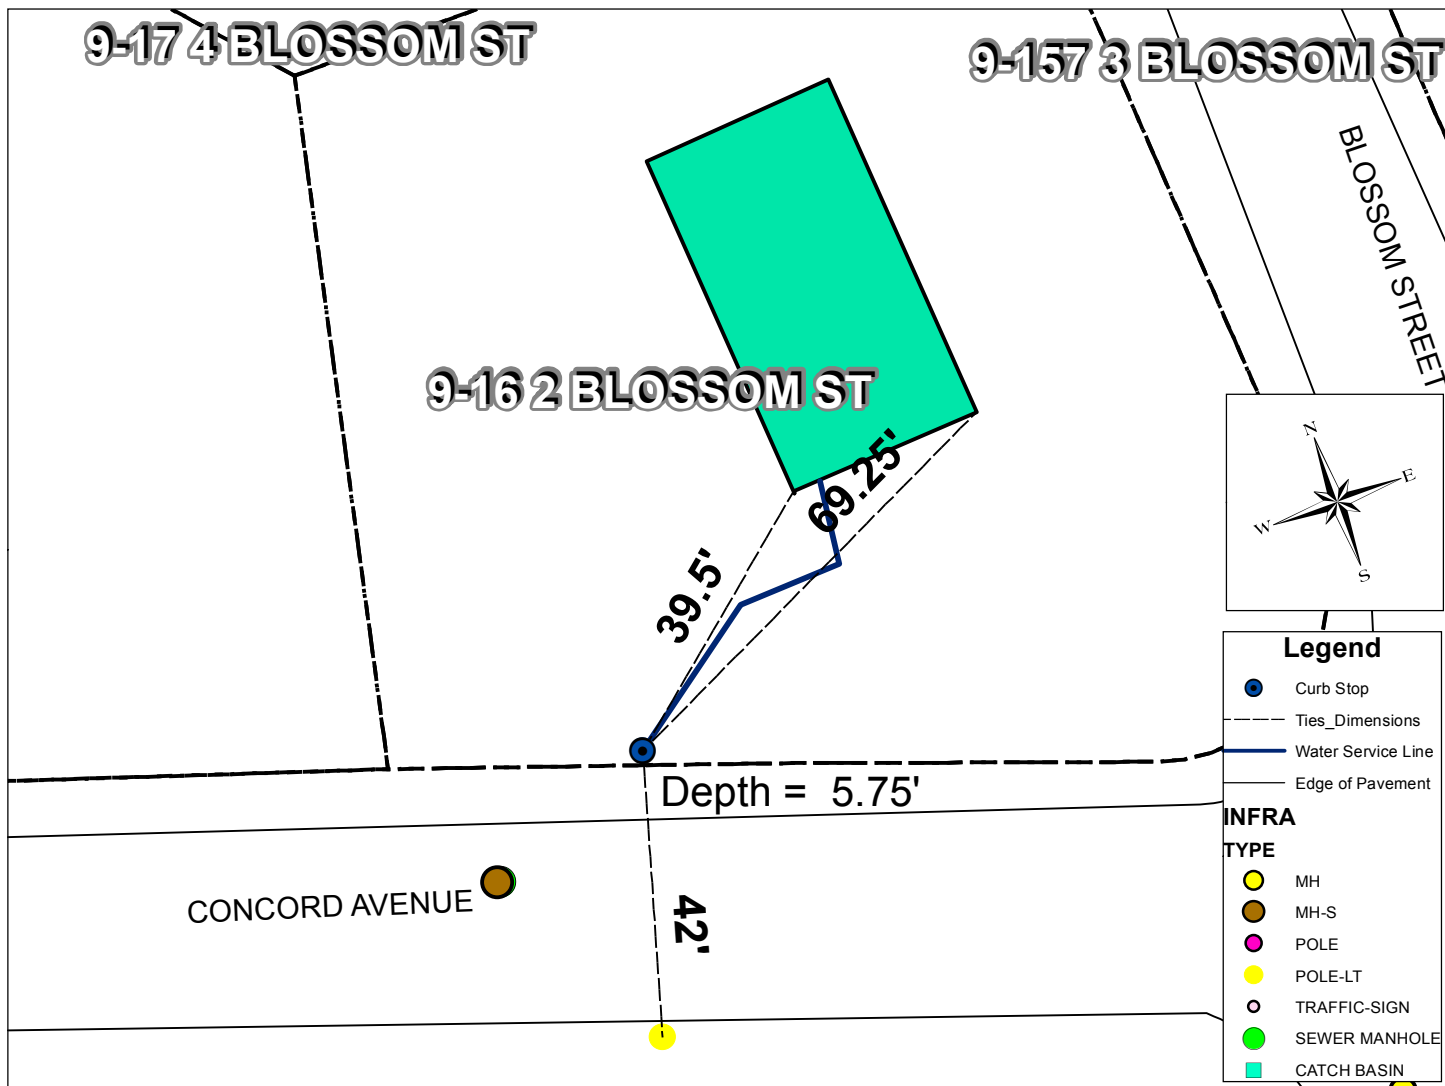

Address	Map and Lot	Permit Number	Contractor Name	Inspector
2 Blossom St	9-16	5354	McLaughlin, James M. Inc.	Dpavlik
Date	Material	Depth of Cover	Amount	
9/1/2013	1" Curb Valve and Buffalo Box 1" Copper type "k"	5.75 ft	1 43 ft to HSE	
Type of work completed				
New 1" water service to house from curb stop. New house on lot old house removed.				